

**Appendix K.8 - Drainage &
Stormwater Management Report**

APPENDIX D


SWM Pond Drawings

NOTES


1. THE LOCATIONS OF ALL UNDERGROUND AND ABOVEGROUND UTILITIES AND STRUCTURES OR BETTER AND TO THE SATISFACTION OF THE CITY OF VAUGHAN AND REGION OF YORK ENGINEERING DEPARTMENTS. GRASSED AREAS WERE TOPPED WITH 100mm TOPSOIL AND SODDED AS PER OPSD-218.01. ALL EXISTING SERVICES WERE ADJUSTED TO SUIT THE FINISH GRADES.

3. CUT AREAS OF POND AND FOREBAY WERE INSPECTED BY THE GEOTECHNICAL INSPECTOR, WHO ADVISED AS TO THE TYPE OF EROSION PROTECTION THAT WAS REQUIRED.
 4. ALL TOPSOIL AND ORGANIC MATERIALS FROM POND AREAS WERE STRIPPED BEFORE PLACING ANY FILL.
 5. ALL EXISTING STRUCTURES, DRIVEWAYS, CULVERTS, BRIDGES WERE REMOVED AND DISPOSED OFF SITE.
 6. SEEDING AND SODDING OF PONDS AS PER LANDSCAPE ARCHITECT DRAWINGS & SPECIFICATIONS.

7. WHERE SAND WAS ENCOUNTERED DURING CONSTRUCTION OF POND, THE UPPER LAYER OF THE SIDE SLOPE AND THE BOTTOM OF THE POND WAS REPLACED WITH A LAYER OF SILTY CLAY TILL MATERIAL. THE THICKNESS WAS DETERMINED BY THE SOIL CONSULTANT AND COMPACTED TO 95% OR A STANDARD PROCTOR DRY DENSITY. AN INTERCEPT SUBDRAIN SYSTEM (SEE DETAIL) WAS ALSO CONSTRUCTED TO STABILIZE THE SIDE.
 8. IN ALL SEWER TRENCHES, WHERE SUBGRADE CONSISTS OF WET SANDS AND SANDY SILT, THE PIPE JOINTS WERE WRAPPED WITH WATERPROOF MEMBRANE.

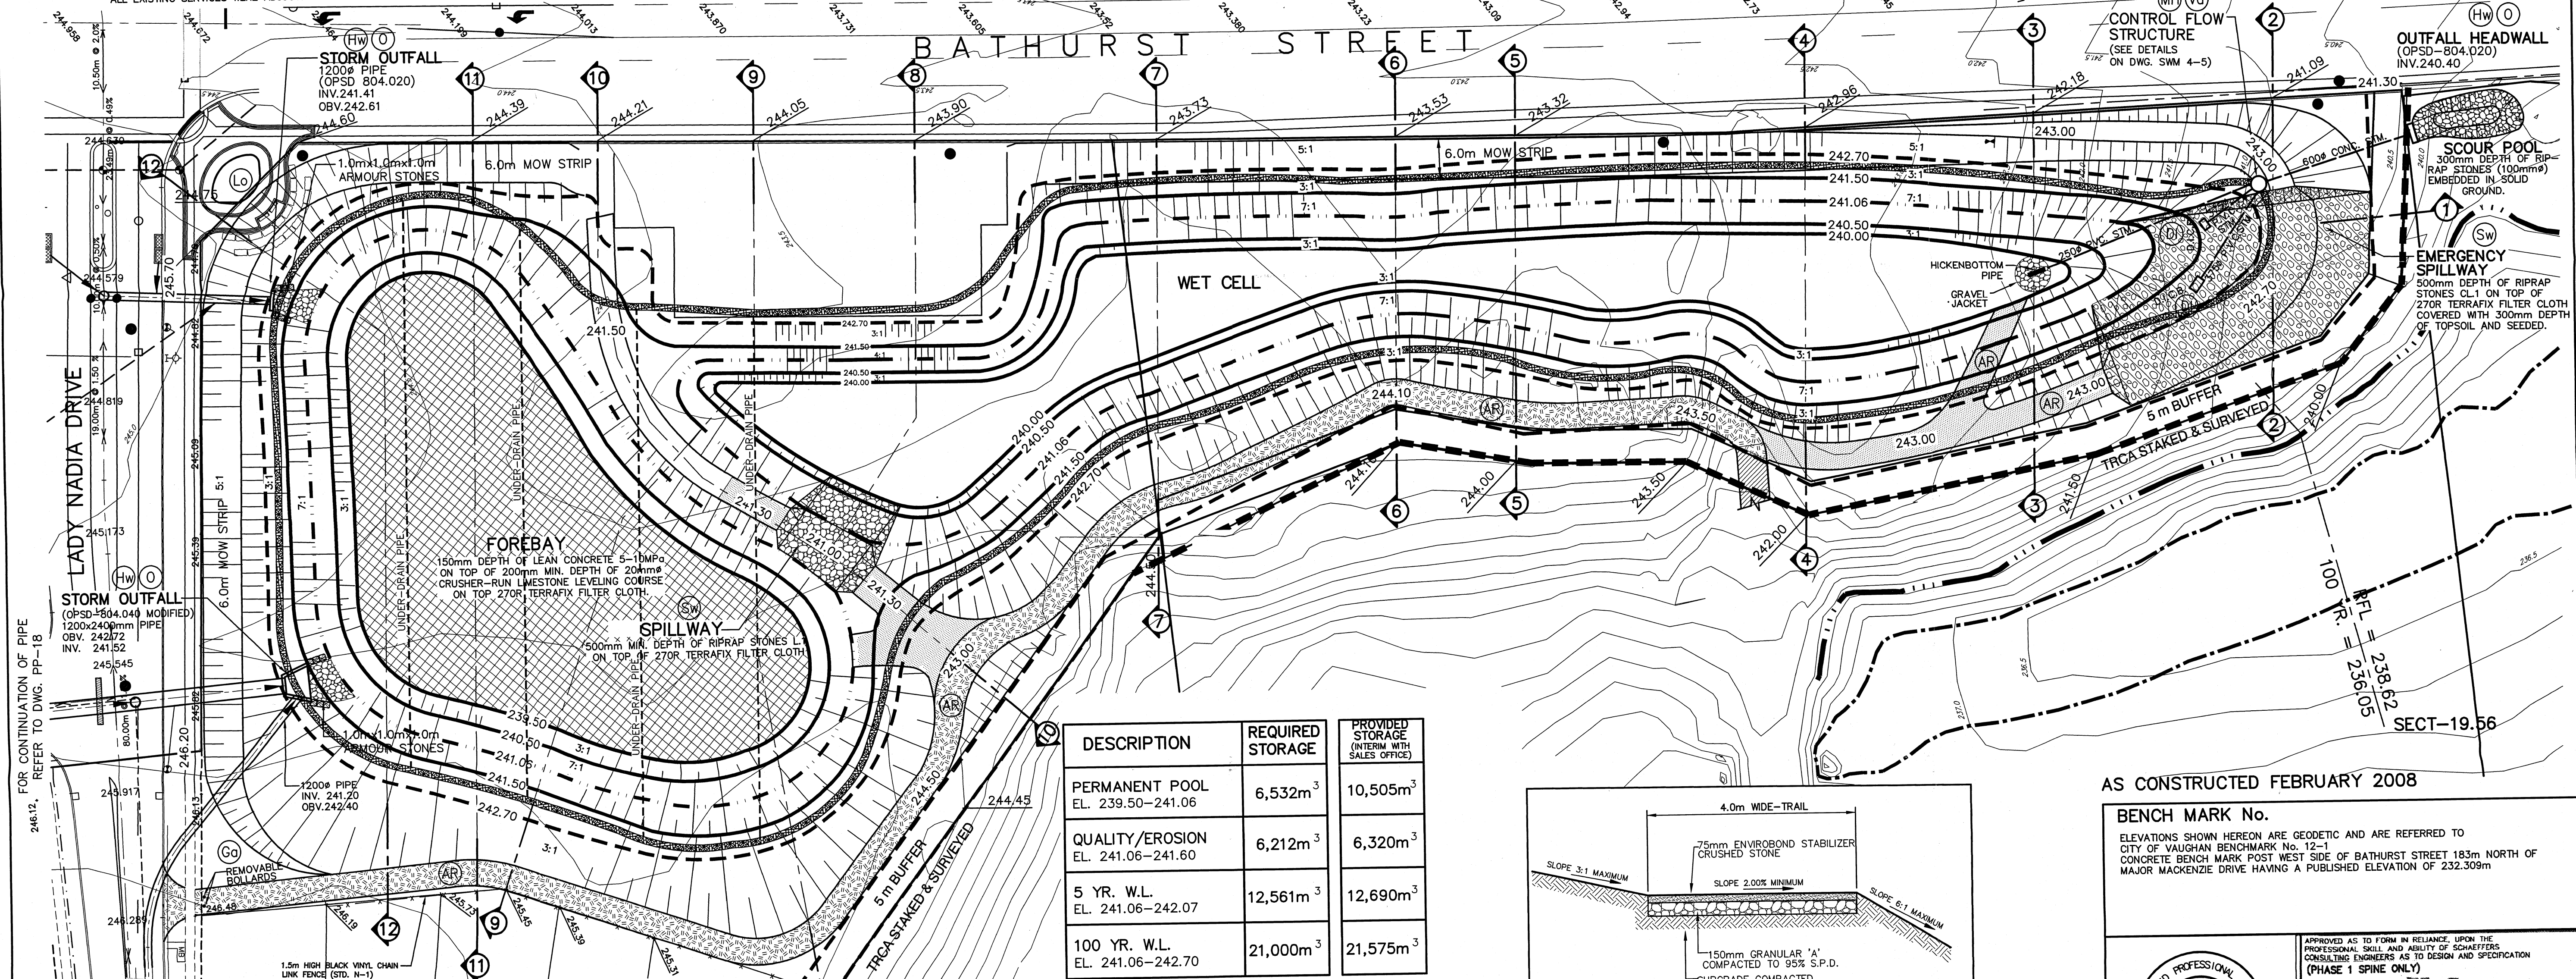

DESCRIPTION	REQUIRED STORAGE	PROVIDED STORAGE (INTERIM WITH SALES OFFICE)
PERMANENT POOL EL. 239.50-241.06	6,532m ³	10,505m ³
QUALITY/EROSION EL. 241.06-241.60	6,212m ³	6,320m ³
5 YR. W.L. EL. 241.06-242.07	12,561m ³	12,690m ³
100 YR. W.L. EL. 241.06-242.70	21,000m ³	21,575m ³





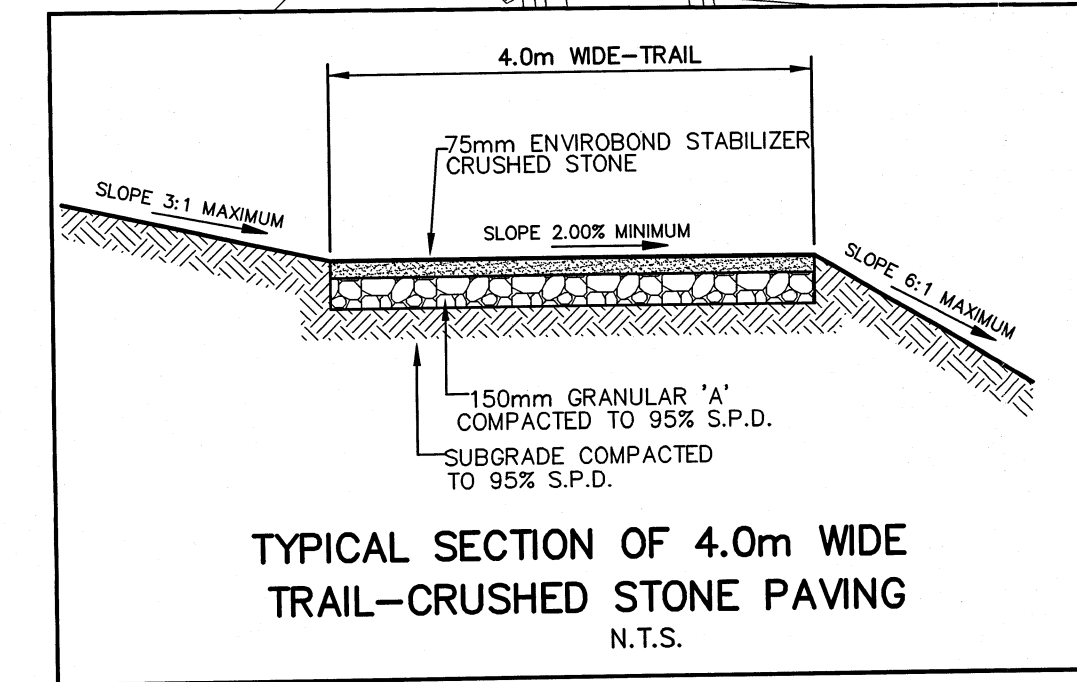


SPECIFICATION FOR CLASS I RIP-RAP STONE:
 100% SMALLER THAN 450mm OR 130kg
 at least 20% LARGER THAN 350mm OR 70kg
 at least 50% LARGER THAN 300mm OR 40kg
 at least 80% LARGER THAN 200mm OR 10kg

REFER TO
 DWG. No. SWM-4-2 FOR SECTIONS 1 - 4
 DWG. No. SWM-4-3 FOR SECTIONS 5 - 8
 DWG. No. SWM-4-4 FOR SECTIONS 9 - 12
 DWG. No. SWM-4-5 FOR FLOW CONTROL STRUCTURE

REVISIONS

No.	DESCRIPTION	By	Date

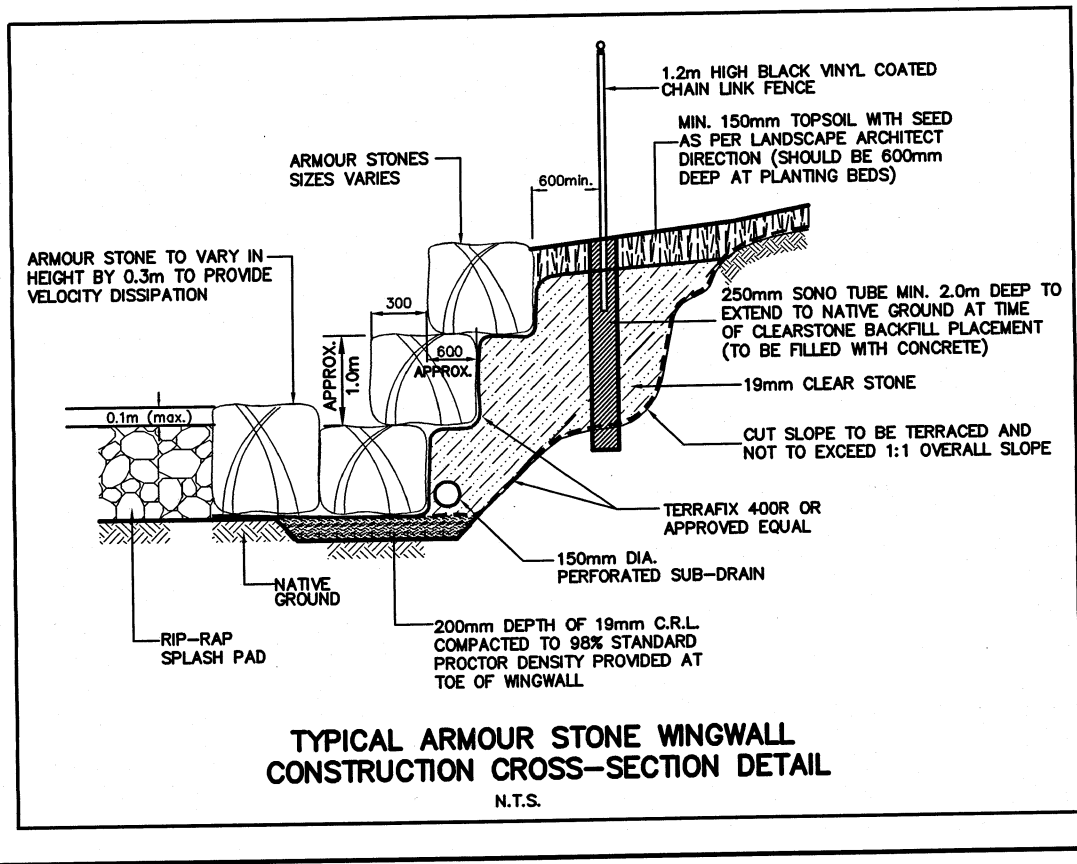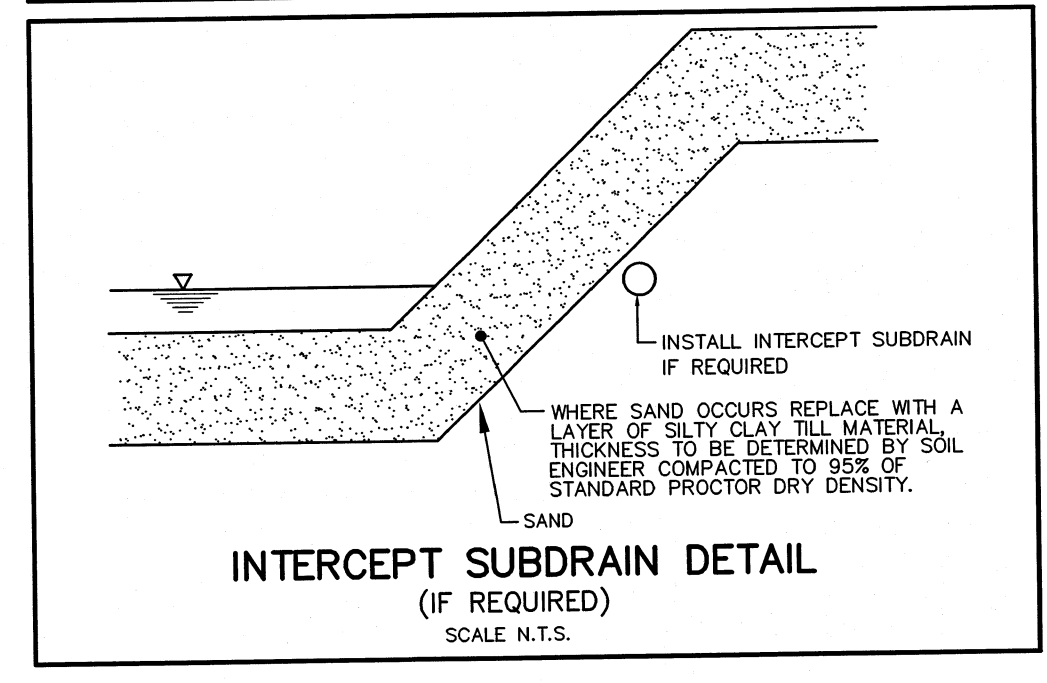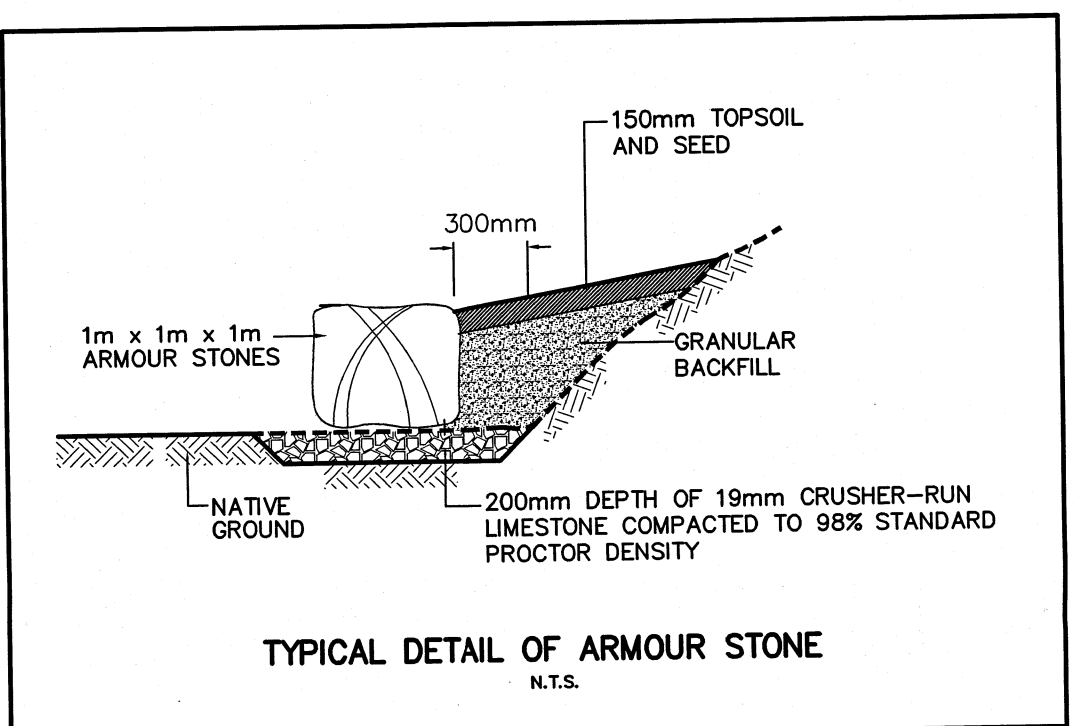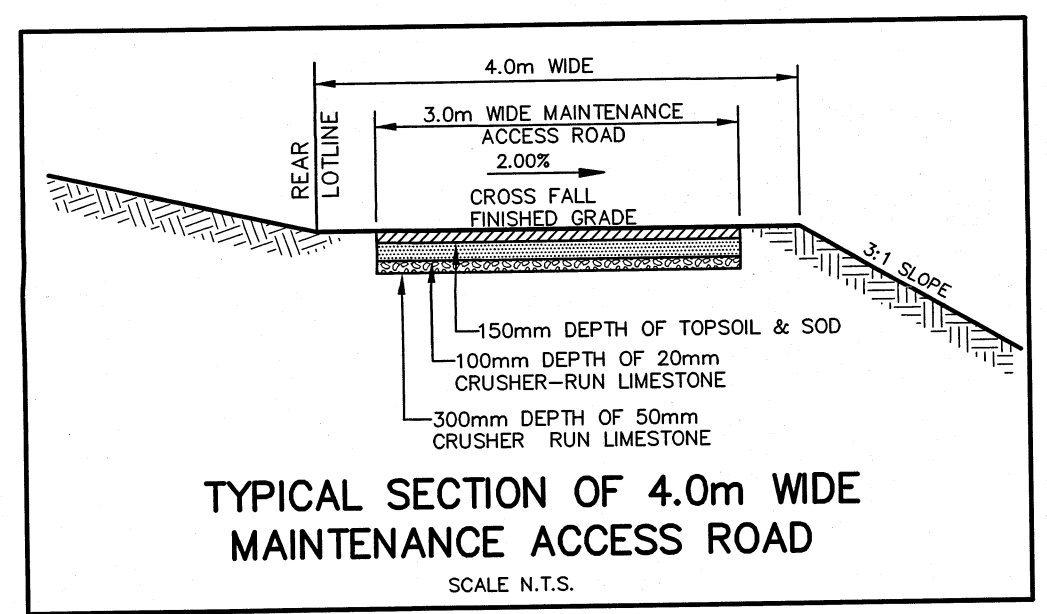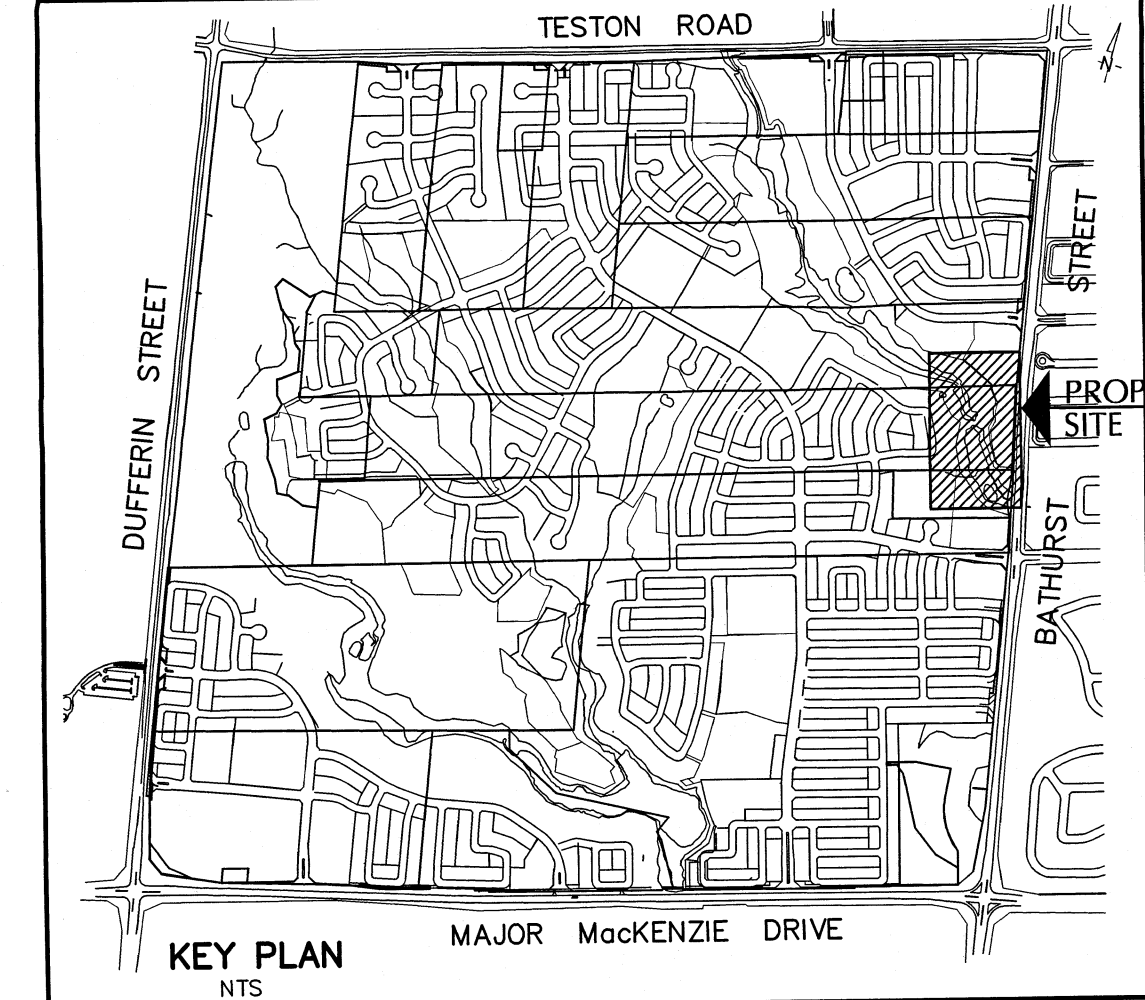

- LEGEND:**
- 245.0 DENOTES ORIGINAL CONTOUR LINE
 - DENOTES PERMANENT POOL LEVEL
 - DENOTES 100 YR. WATER LEVEL
 - DENOTES FINISH POND CONTOUR LINE
 - DENOTES MAINTENANCE ACCESSROAD ONLY (TURFSTONE)
 - DENOTES 150mm DEPTH OF LEAN CONCRETE (5-10MPa) ON TOP OF 200mm DEPTH OF 20mm CRUSHER RUN LIMESTONE LEVELLING COURSE, ON TOP OF 270R TERRAFIX FILTER CLOTH
 - DENOTES TRAIL ONLY (CRUSHED STONE PAVING)
 - DENOTES MAINTENANCE ACCESS ROAD (TURFSTONE)
 - DENOTES RIPRAP STONE ON TOP OF 270R TERRAFIX FILTER CLOTH
 - DENOTES RIPRAP STONE ON TOP OF 270R TERRAFIX FILTER CLOTH, COVERED WITH 300mm TOPSOIL AND SEEDED.
 - 210.07 DENOTES FINISH GRADE
 - DENOTES 300# BIG 'O' WEEPER+FF.SOCK BOSS 1000
 - DENOTES 1m x 1m x 1m LEDGE ROCKS
 - G.W.L. DENOTES GROUNDWATER LINE
 - DENOTES UNDER-DRAIN PIPE

AS CONSTRUCTED FEBRUARY 2008

BENCH MARK No.
 ELEVATIONS SHOWN HEREON ARE GEODETIC AND ARE REFERRED TO CITY OF VAUGHAN BENCHMARK No. 12-1 CONCRETE BENCH MARK POST WEST SIDE OF BATHURST STREET 183m NORTH OF MAJOR MACKENZIE DRIVE HAVING A PUBLISHED ELEVATION OF 232.309m

APPROVED AS TO FORM IN RELIANCE UPON THE PROFESSIONAL SKILL AND ABILITY OF SCHAEFFERS CONSULTING ENGINEERS AS TO DESIGN AND SPECIFICATION (PHASE 1 SPINE ONLY)

Vaughan
 The City Above Toronto
CONSTRUCTION DRAWING
 June 30, 2011
 DIRECTOR OF DEVELOPMENT/ TRANSPORTATION ENGINEERING DATE

BLOCK 12 SPINE SERVICES

SCHAEFFERS
 CONSULTING ENGINEERS
 6 Ronrose Drive, Concord, Ontario L4K 4R3
 Tel: (905) 738-6100
 Fax: (905) 738-6875
 E-mail: design@schaeffers.com
 SCHAEFFER & ASSOCIATES LTD.

PROJECT No. 2004-2644 DRAWING No. SWM 4-1

HORIZONTAL SCALE: 0 5 10 15 20 25 30 35 40 45 50m
 VERTICAL SCALE: 0 1 2 3 4 5 6 7 8 9 10m





Vaughan
 The City Above Toronto

BLOCK 12
 PLAN
 SWM POND No. 4

DESIGNED BY: A.B.O. DATE: SEPT. 2004 CHECKED BY:
 DRAWN BY: RMM/I.V. APPROVED BY:
 SCALE: 1:500 19T-99V08 DWG. No.
 19T-03V17

H:\4 Construction\2004\2004-2644-SWM-1.dwg, 10/8/2013 3:43:08 PM, mshin, User 2 (850.00 x 600.00 MM)

REVISIONS			
No.	DESCRIPTION	By	Date

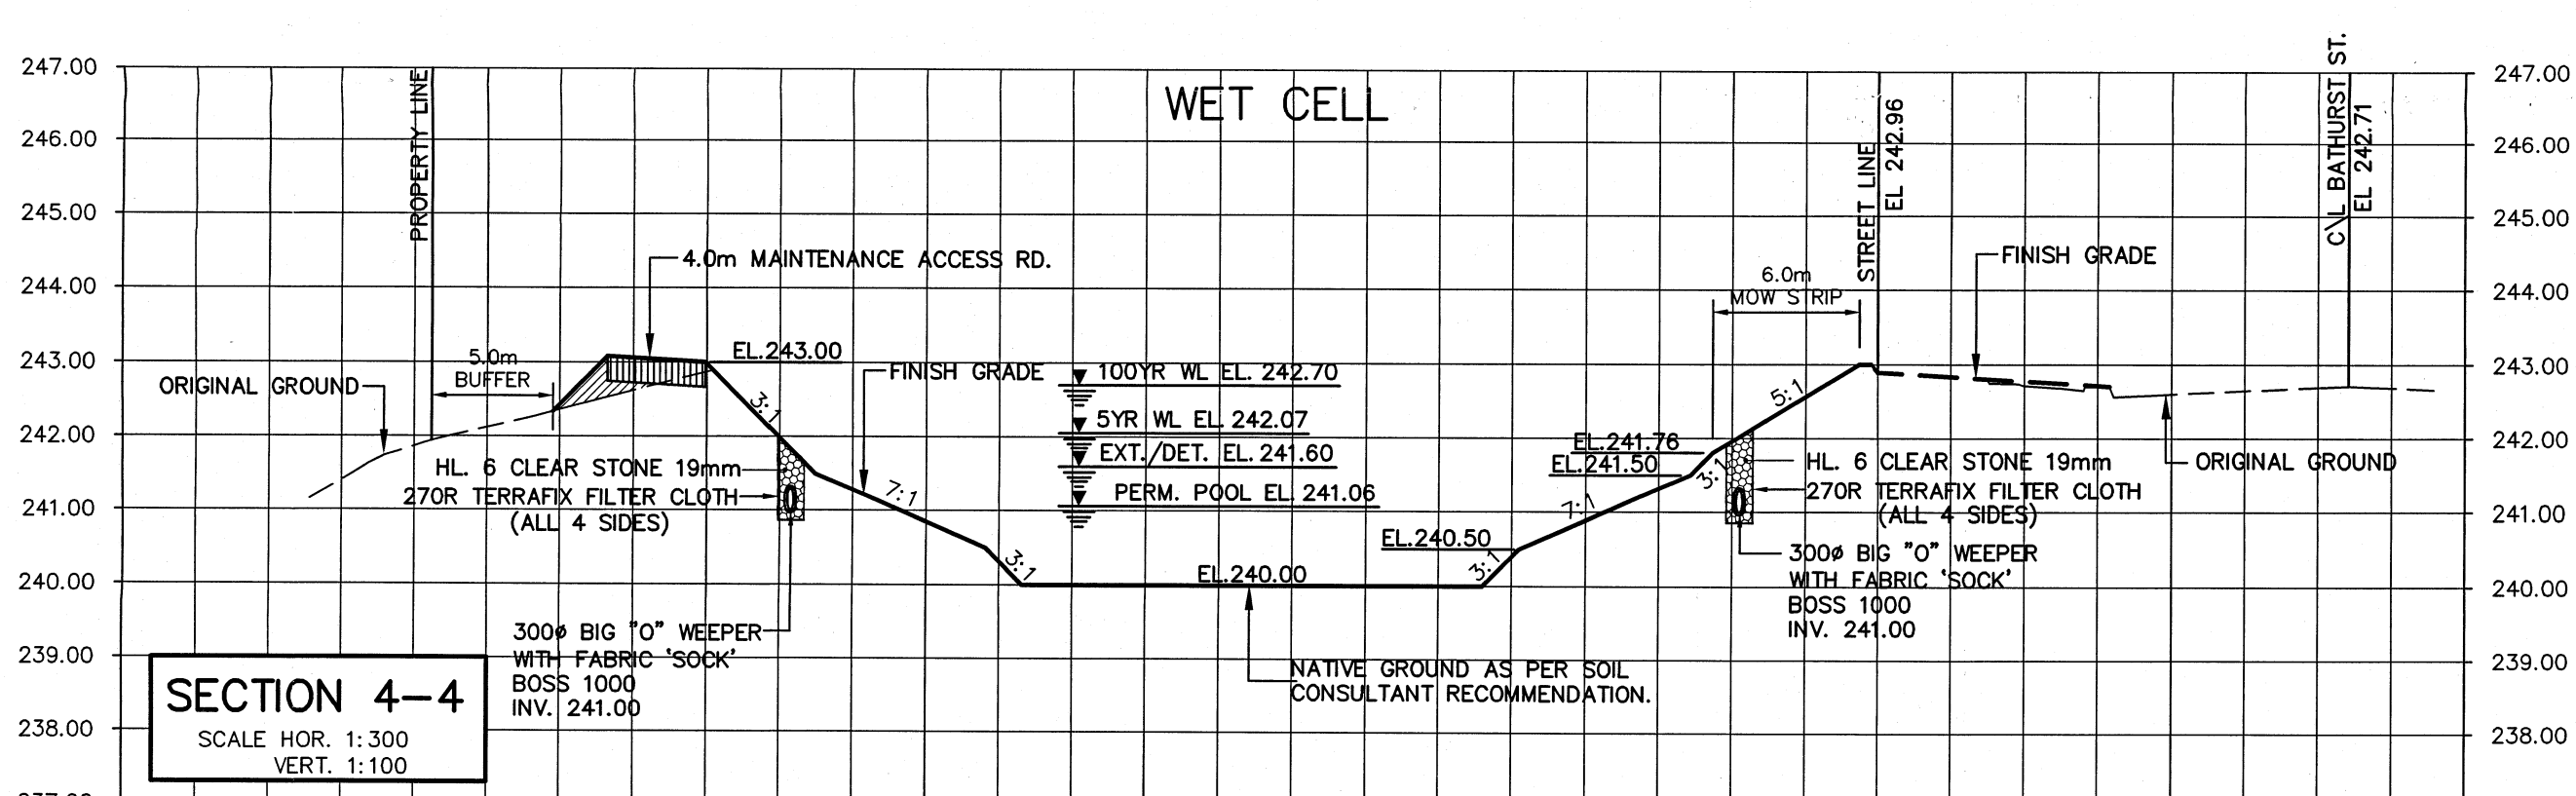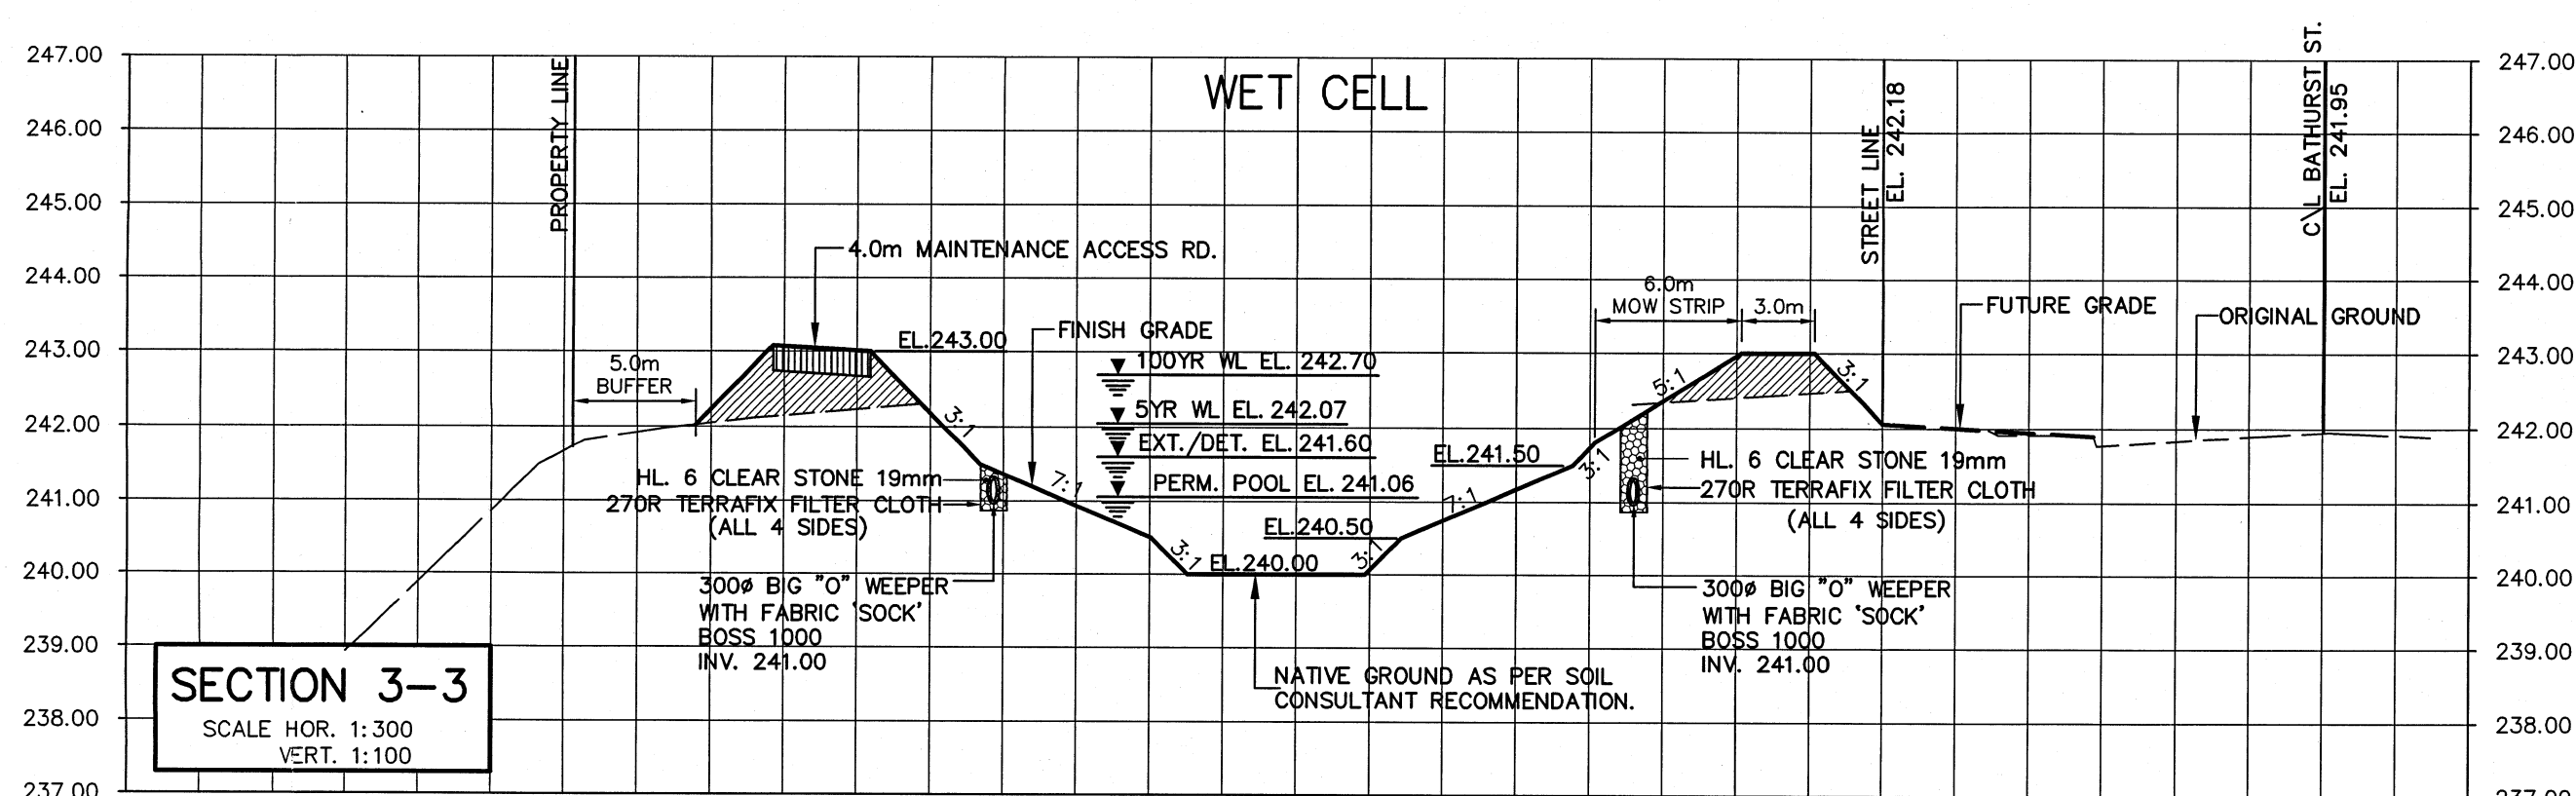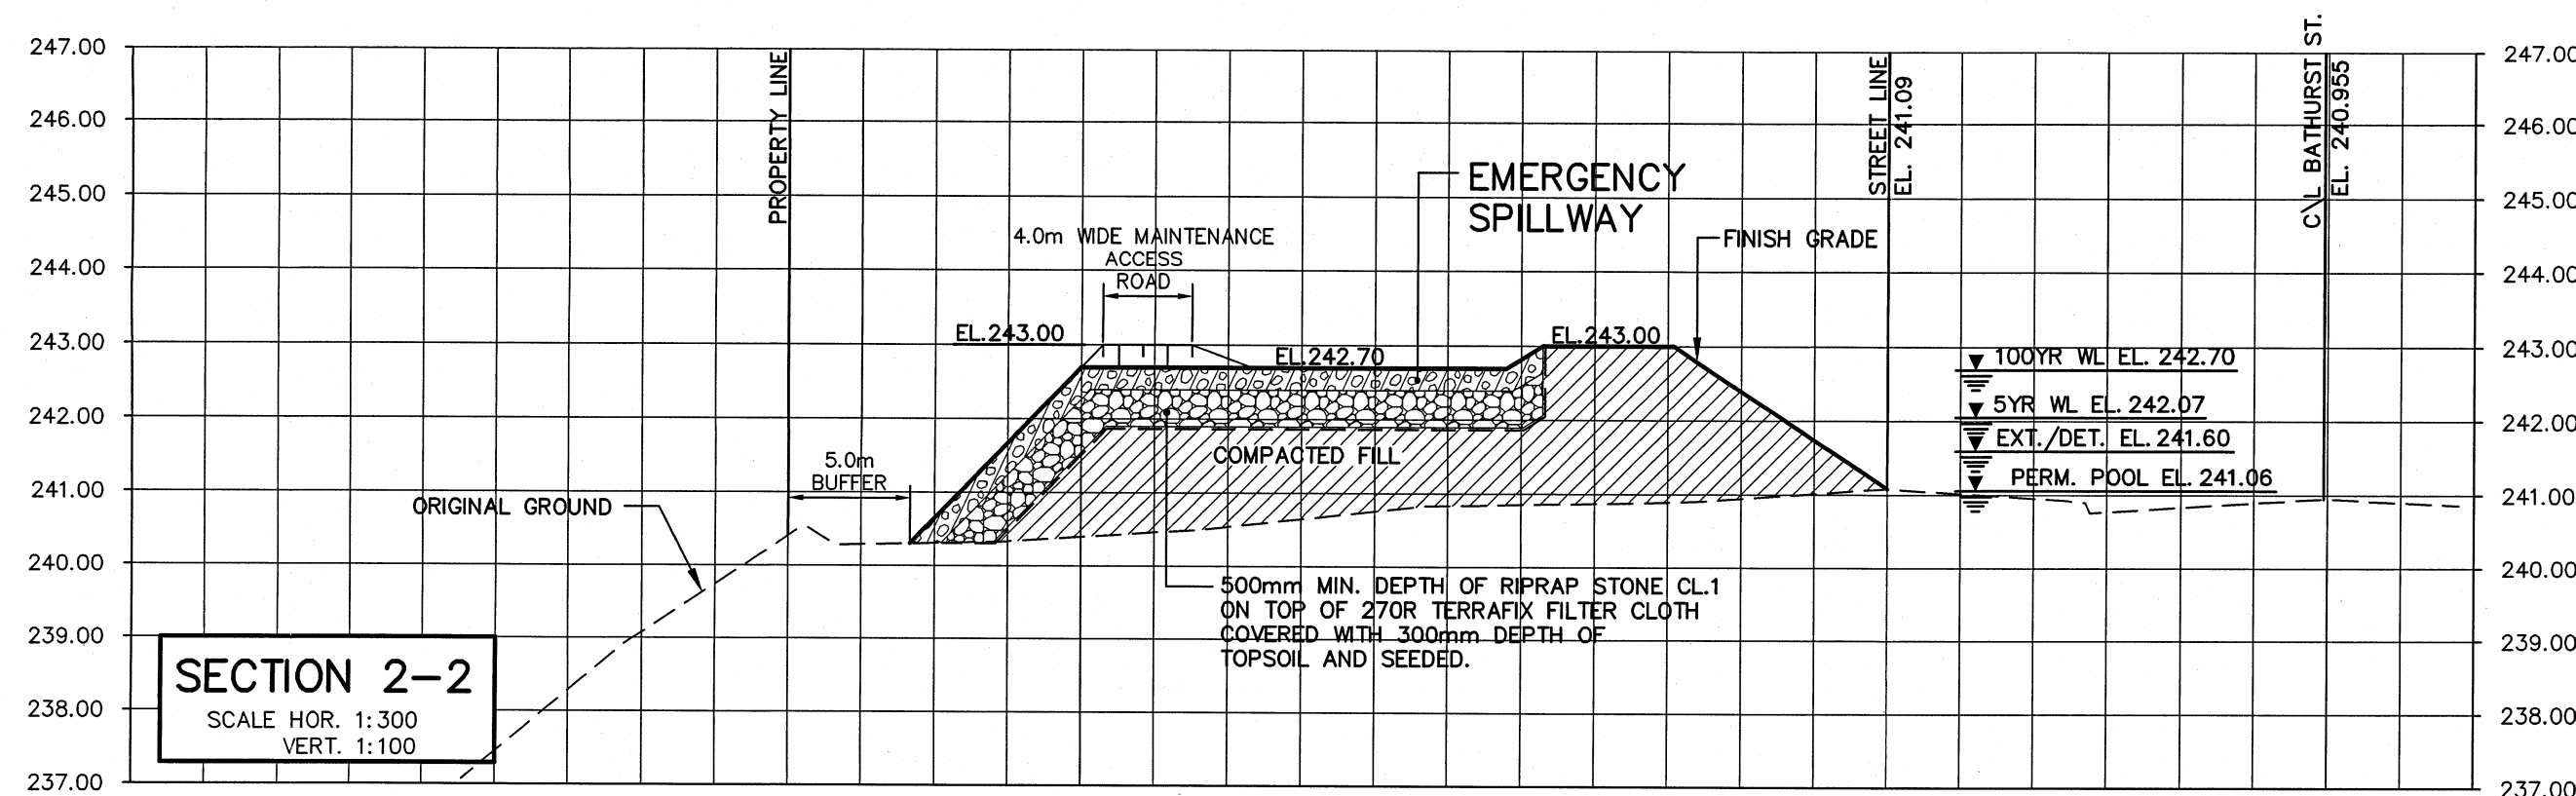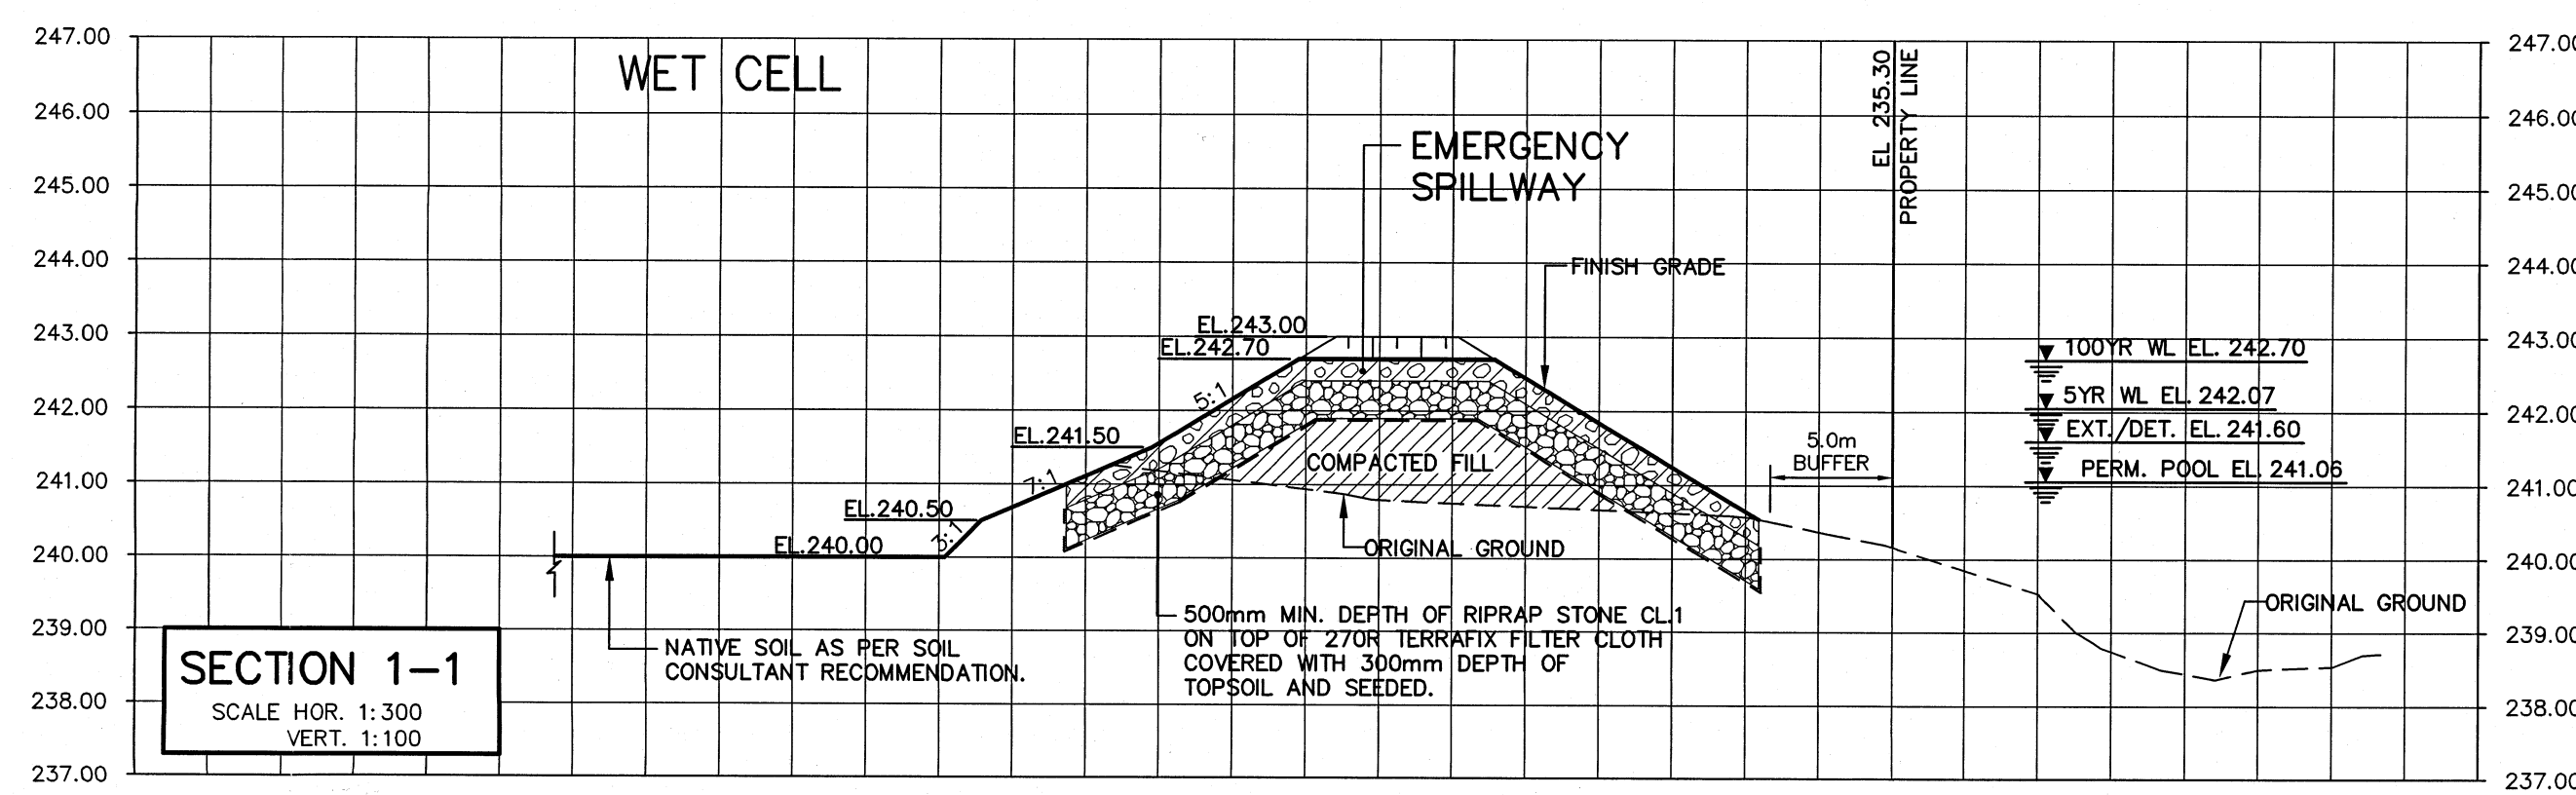

AS CONSTRUCTED FEBRUARY 2008

BENCH MARK No.
 ELEVATIONS SHOWN HEREON ARE GEODETIC AND ARE REFERRED TO CITY OF VAUGHAN BENCHMARK No. 12-1 CONCRETE BENCHMARK POST WEST SIDE OF BATHURST STREET 183m NORTH OF MAJOR MACKENZIE DRIVE HAVING A PUBLISHED ELEVATION OF 232.309m

APPROVED AS TO FORM IN RELIANCE UPON THE PROFESSIONAL SKILL AND ABILITY OF SCHAEFFERS CONSULTING ENGINEERS AS TO DESIGN AND SPECIFICATION (PHASE 1 SPINE ONLY)

Vaughan
The City Above Toronto

CONSTRUCTION DRAWING
June 30, 2011

DIRECTOR OF DEVELOPMENT/TRANSPORTATION ENGINEERING DATE

BLOCK 12 SPINE SERVICES

SCHAEFFERS
CONSULTING ENGINEERS

SCHAEFFER & ASSOCIATES LTD.

6 Ronrose Drive, Concord, Ontario L4K 4R3
 Tel: (905) 738-6100
 Fax: (905) 738-6875
 E-mail: design@schaeffers.com





PROJECT No.	2004-2644	DRAWING No.	SWM 4-2
SCALE	HORIZONTAL	0 5 10 15 20 25 30 35 40 45 50m	
	VERTICAL	0 1 2 3 4 5 6 7 8 9 10m	



SWM POND No. 4
SECTIONS 1-1 TO 4-4

DESIGNED BY: A.B.O.	DATE: MAY 2005	CHECKED BY: H.T.
DRAWN BY: AMR/Acad		APPROVED BY:
SCALE: AS SHOWN		DWG. No.

REVISIONS			
No.	DESCRIPTION	By	Date

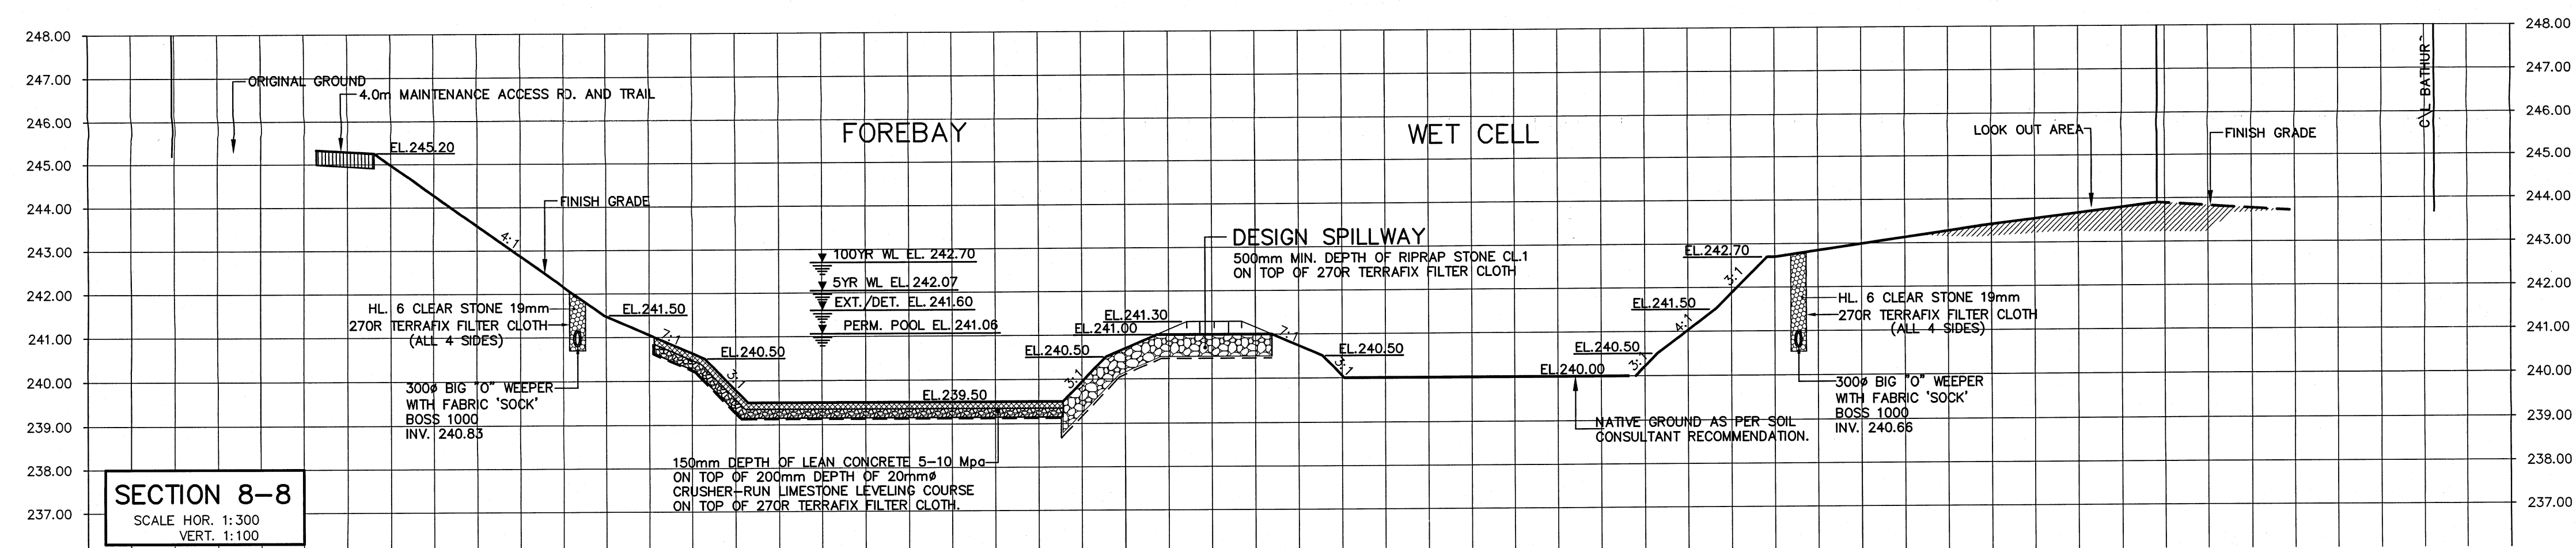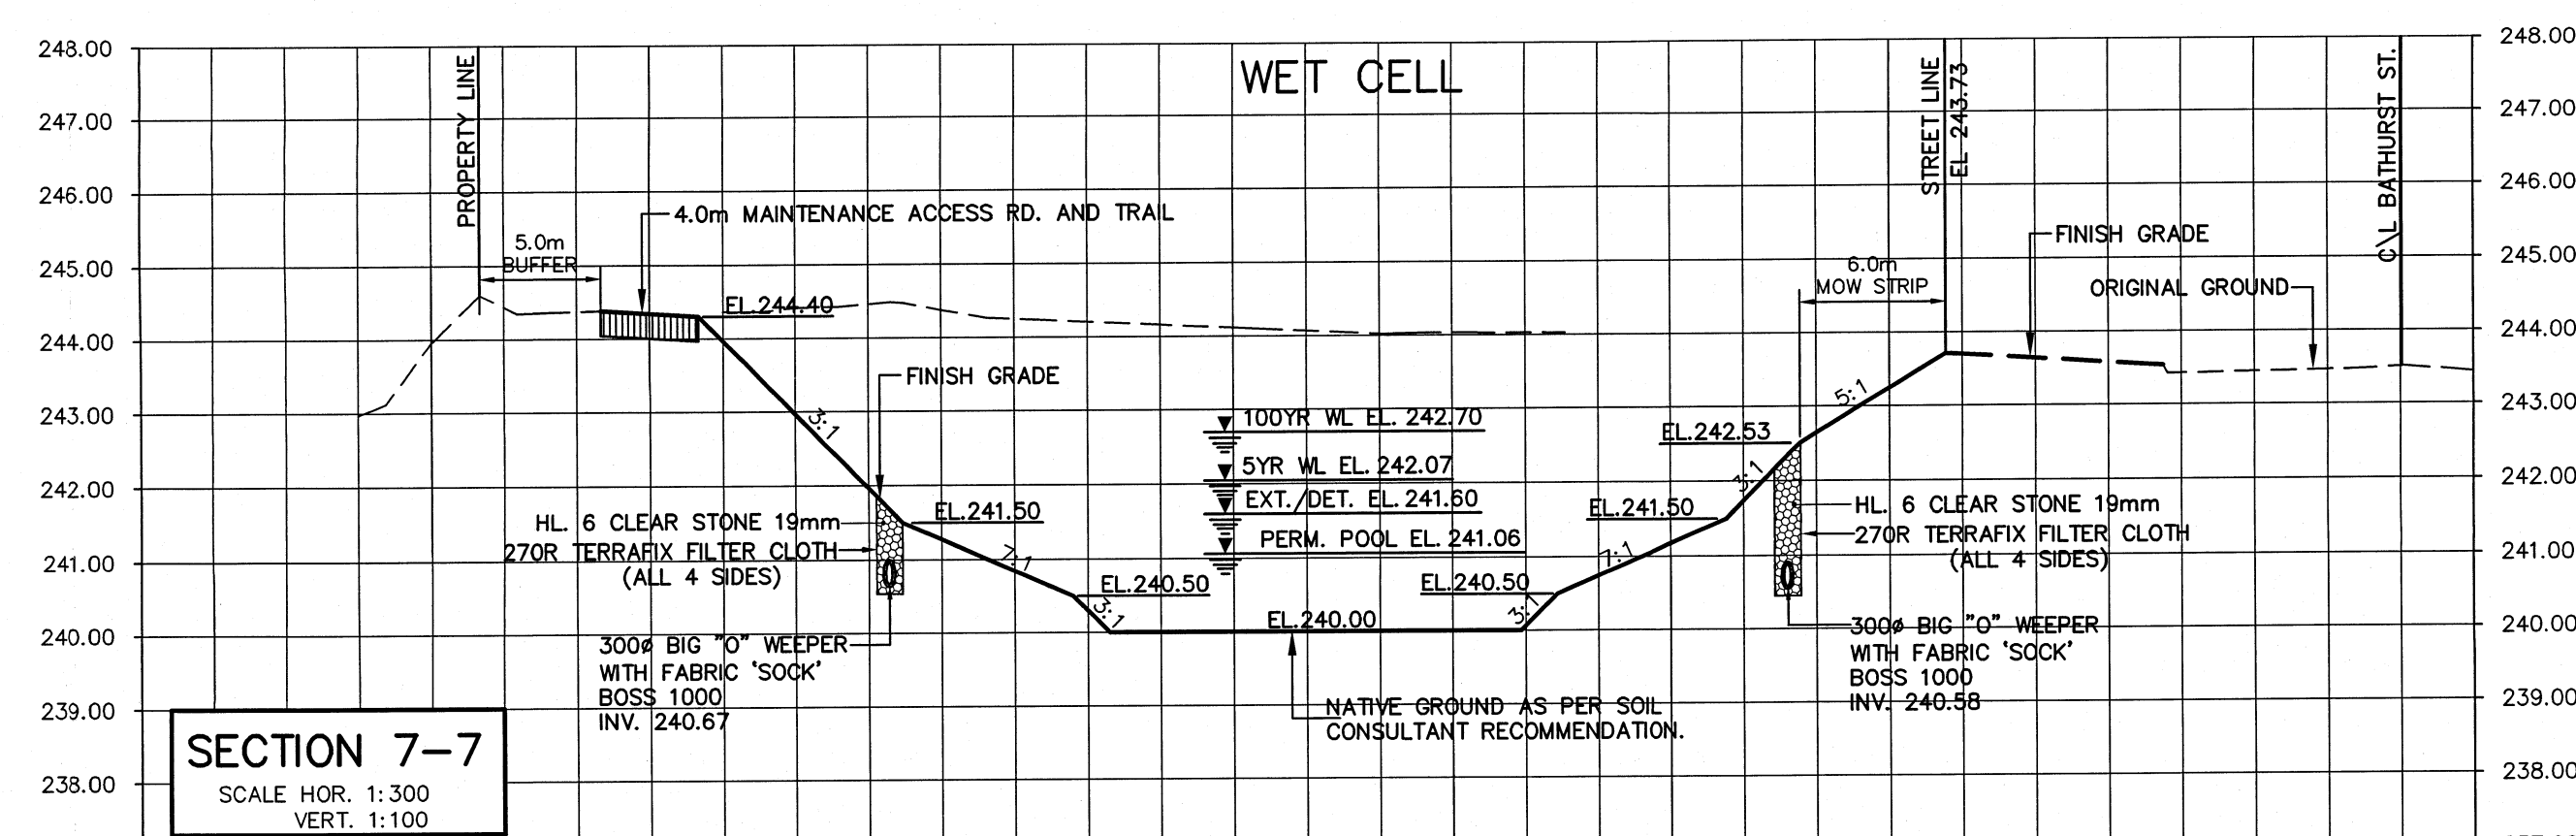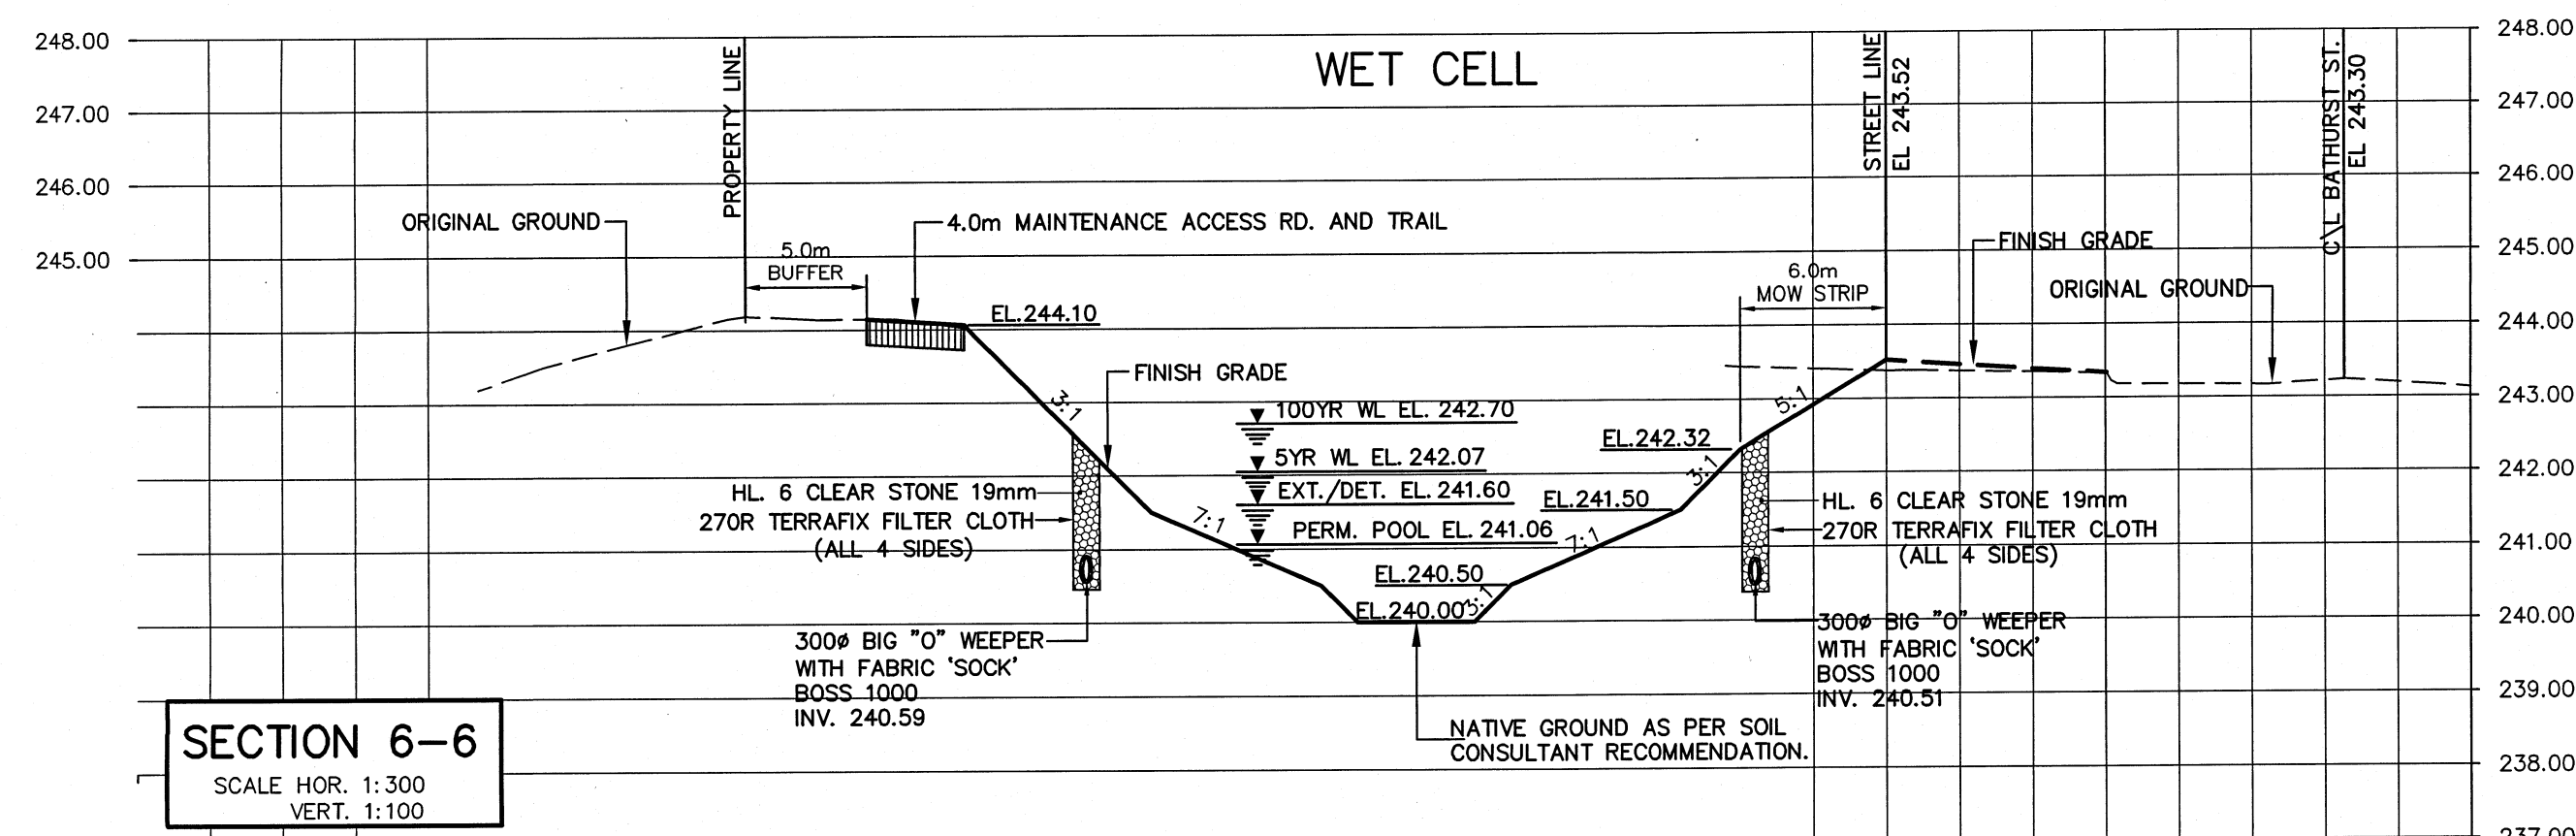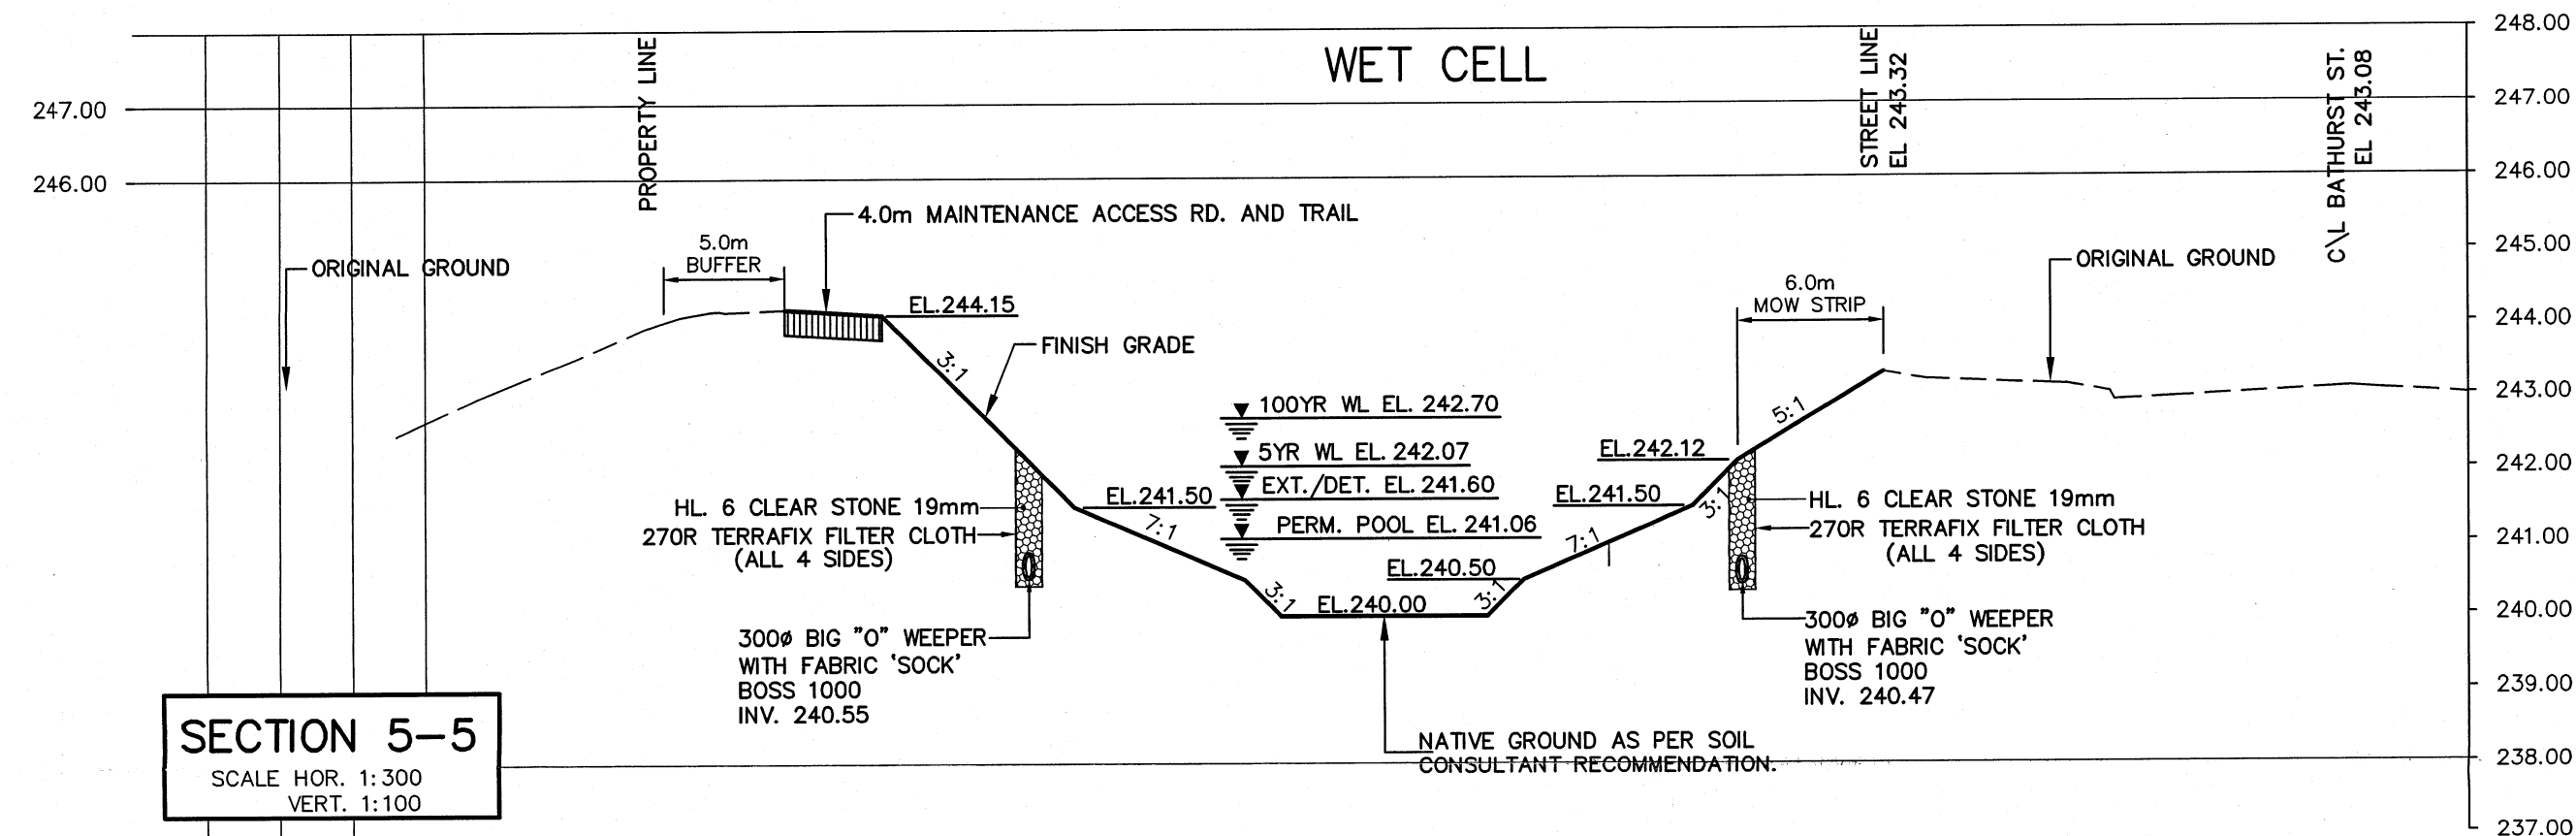

AS CONSTRUCTED FEBRUARY 2008

BENCH MARK No.
 ELEVATIONS SHOWN HEREON ARE GEODETIC AND ARE REFERRED TO CITY OF VAUGHAN BENCHMARK No. 12-1 CONCRETE BENCH MARK POST WEST SIDE OF BATHURST STREET 183m NORTH OF MAJOR MACKENZIE DRIVE HAVING A PUBLISHED ELEVATION OF 232.309m

APPROVED AS TO FORM IN RELIANCE UPON THE PROFESSIONAL SKILL AND ABILITY OF SCHAEFFERS CONSULTING ENGINEERS AS TO DESIGN AND SPECIFICATION (PHASE 1 SPINE ONLY)

Vaughan
The City Above Toronto

CONSTRUCTION DRAWING
June 30, 2011

DIRECTOR OF DEVELOPMENT/ TRANSPORTATION ENGINEERING DATE

BLOCK 12 SPINE SERVICES


SCHAEFFERS
CONSULTING ENGINEERS

SCHAEFFER & ASSOCIATES LTD.

6 Ronrose Drive, Concord,
Ontario L4K 4R3
Tel: (905) 738-6100
Fax: (905) 738-6875
E-mail: design@schaeffers.com

PROJECT No. **2004-2644** DRAWING No. **SWM 4-3**

HORIZONTAL 0 5 10 15 20 25 30 35 40 45 50m
 VERTICAL 0 1 2 3 4 5 6 7 8 9 10m




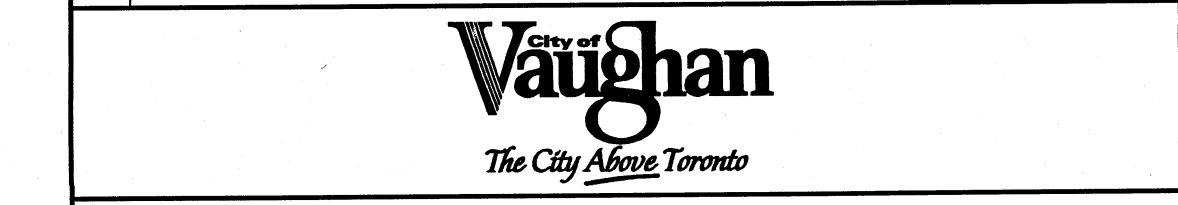


SWM POND No. 4
SECTIONS 5-5 TO 8-8

DESIGNED BY: A.B.O.	DATE: MAY 2005	CHECKED BY: H.T.
DRAWN BY: AMR/Acad		APPROVED BY:
SCALE: AS SHOWN		DWG. No.

H:\As Constructed\2644-AC\2644SWM4-3.dwg, 10/22/2013 10:13:21 AM, mshh, User 2 (850.00 x 600.00 MM)

REVISIONS			
No.	DESCRIPTION	By	Date

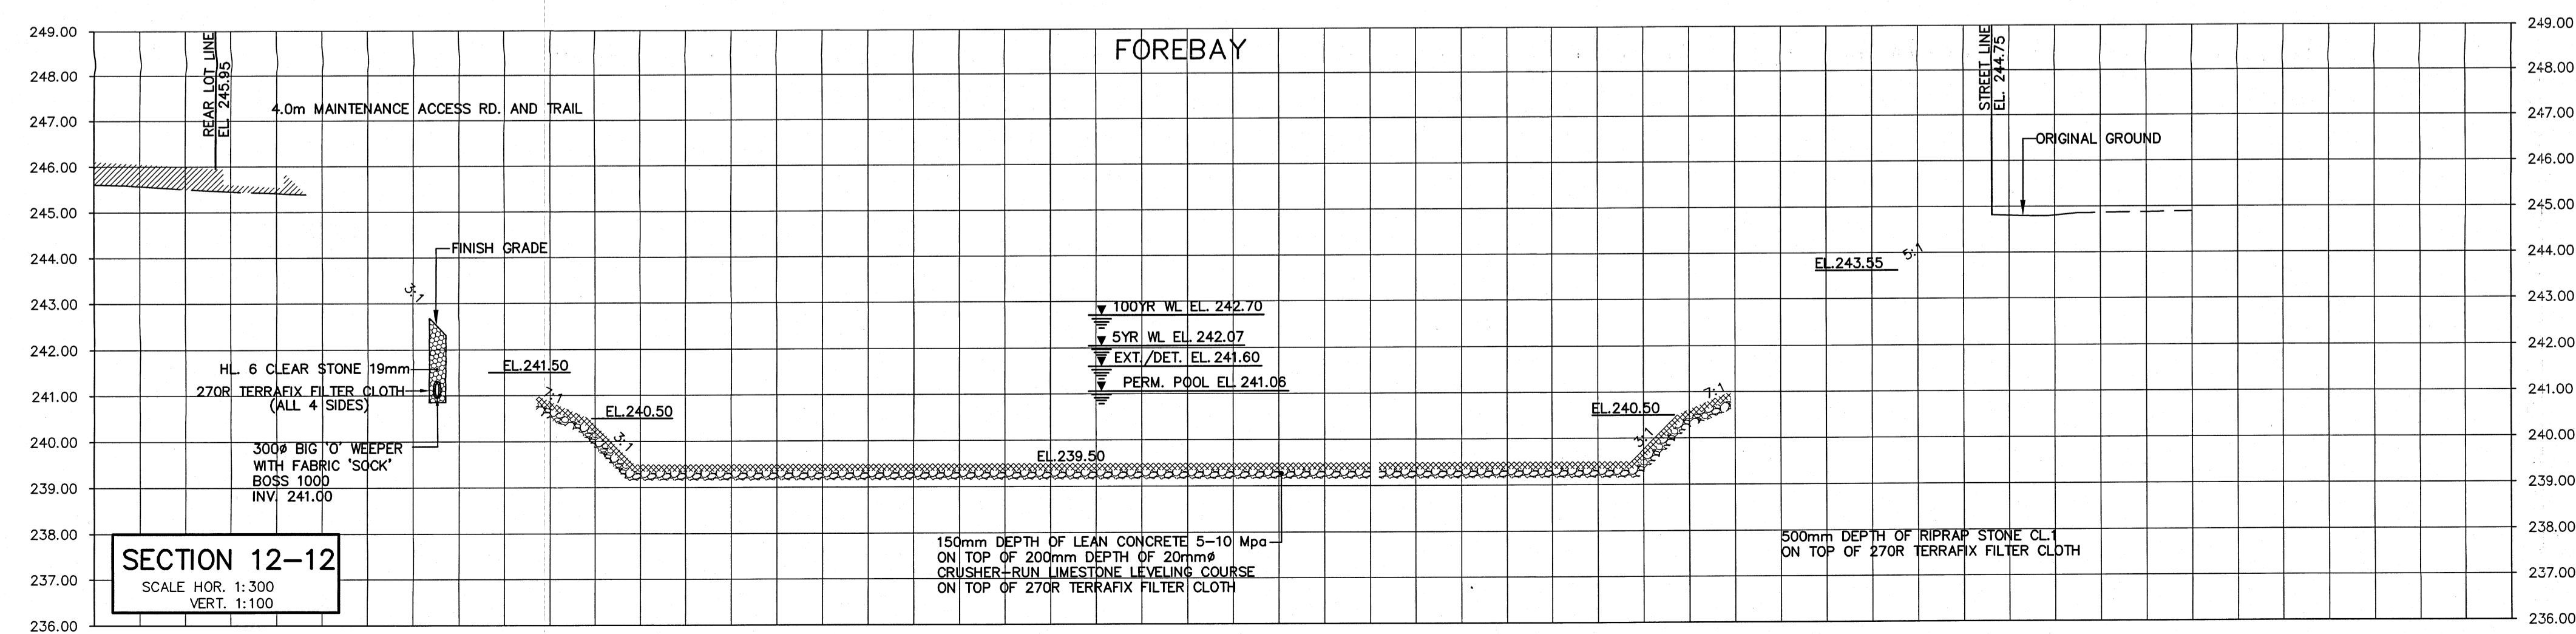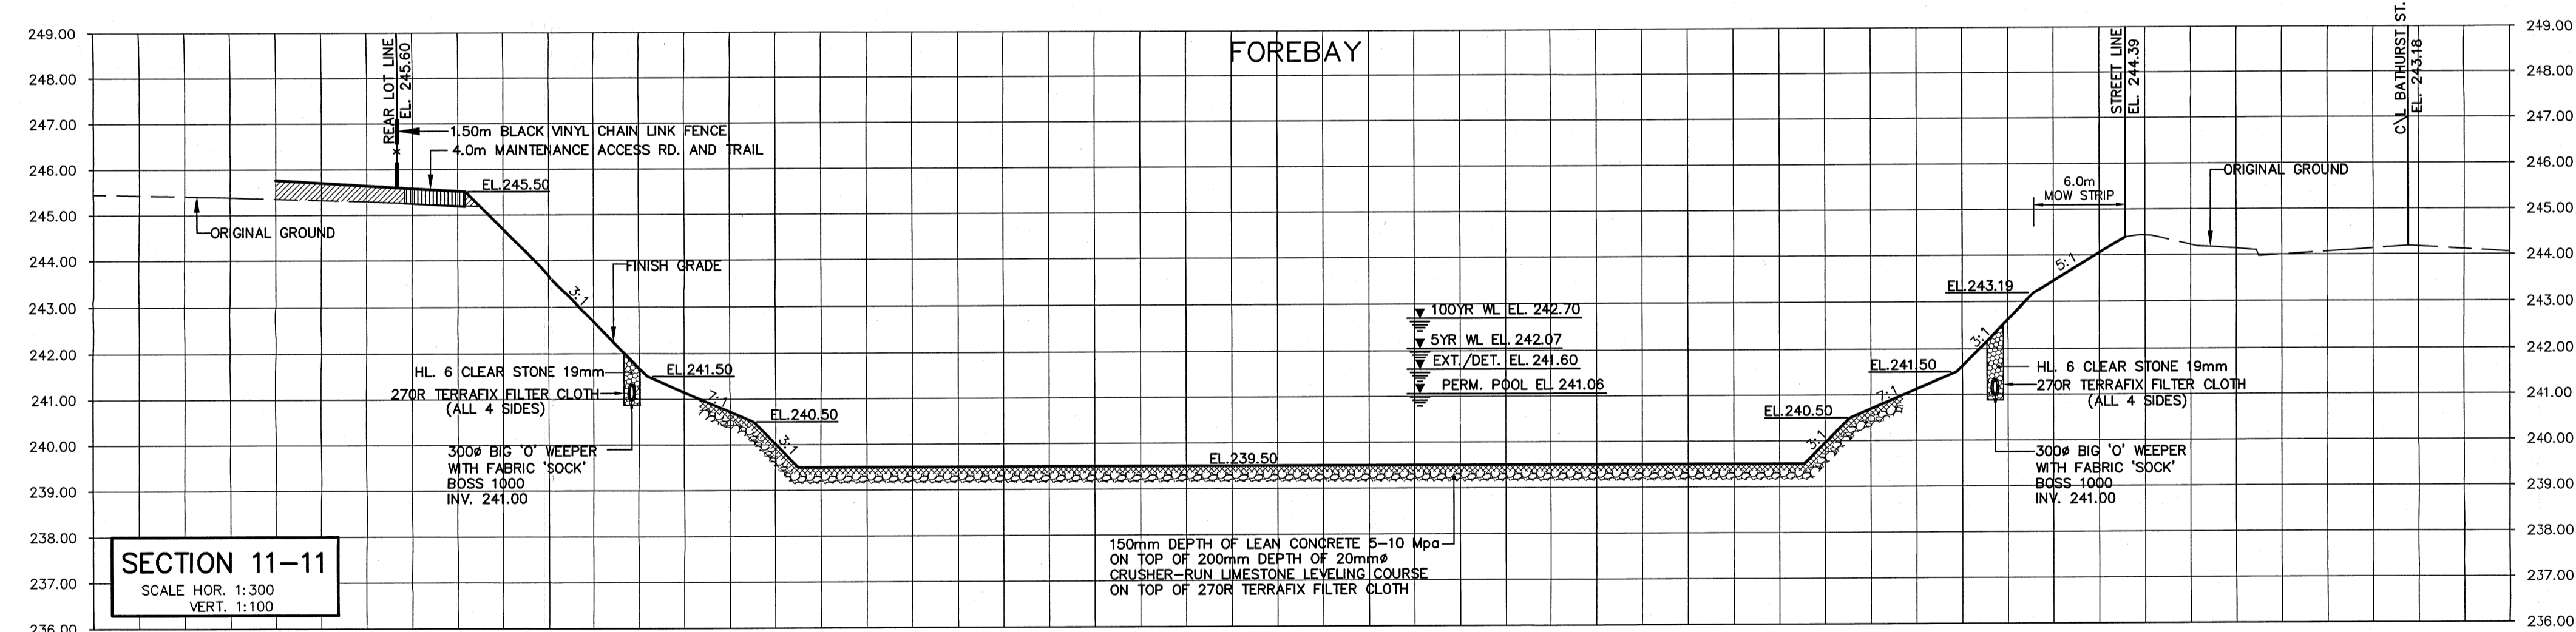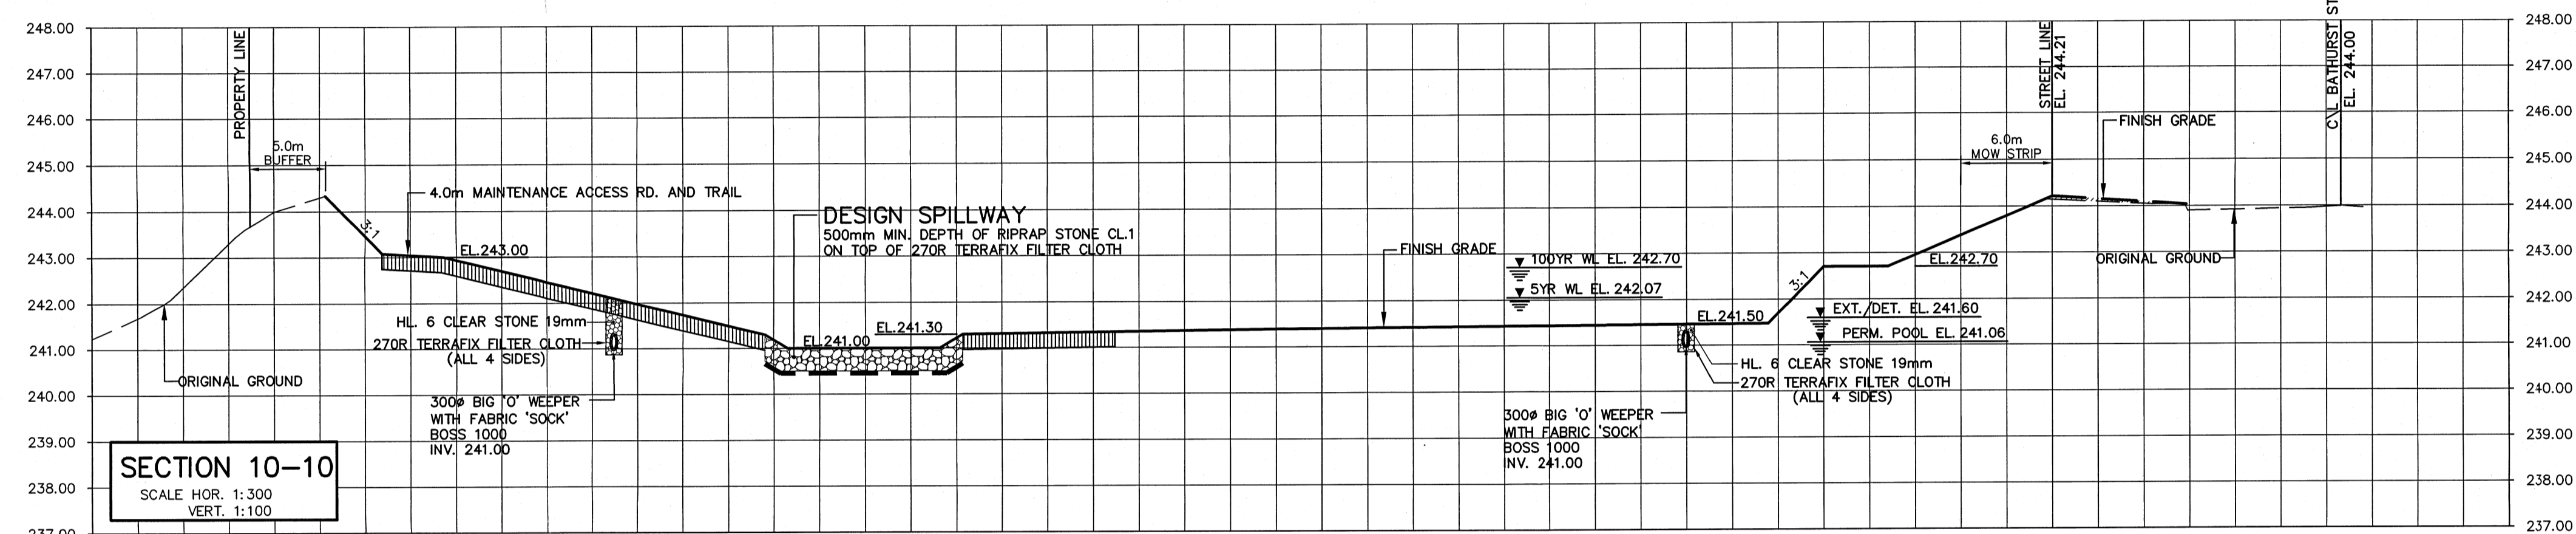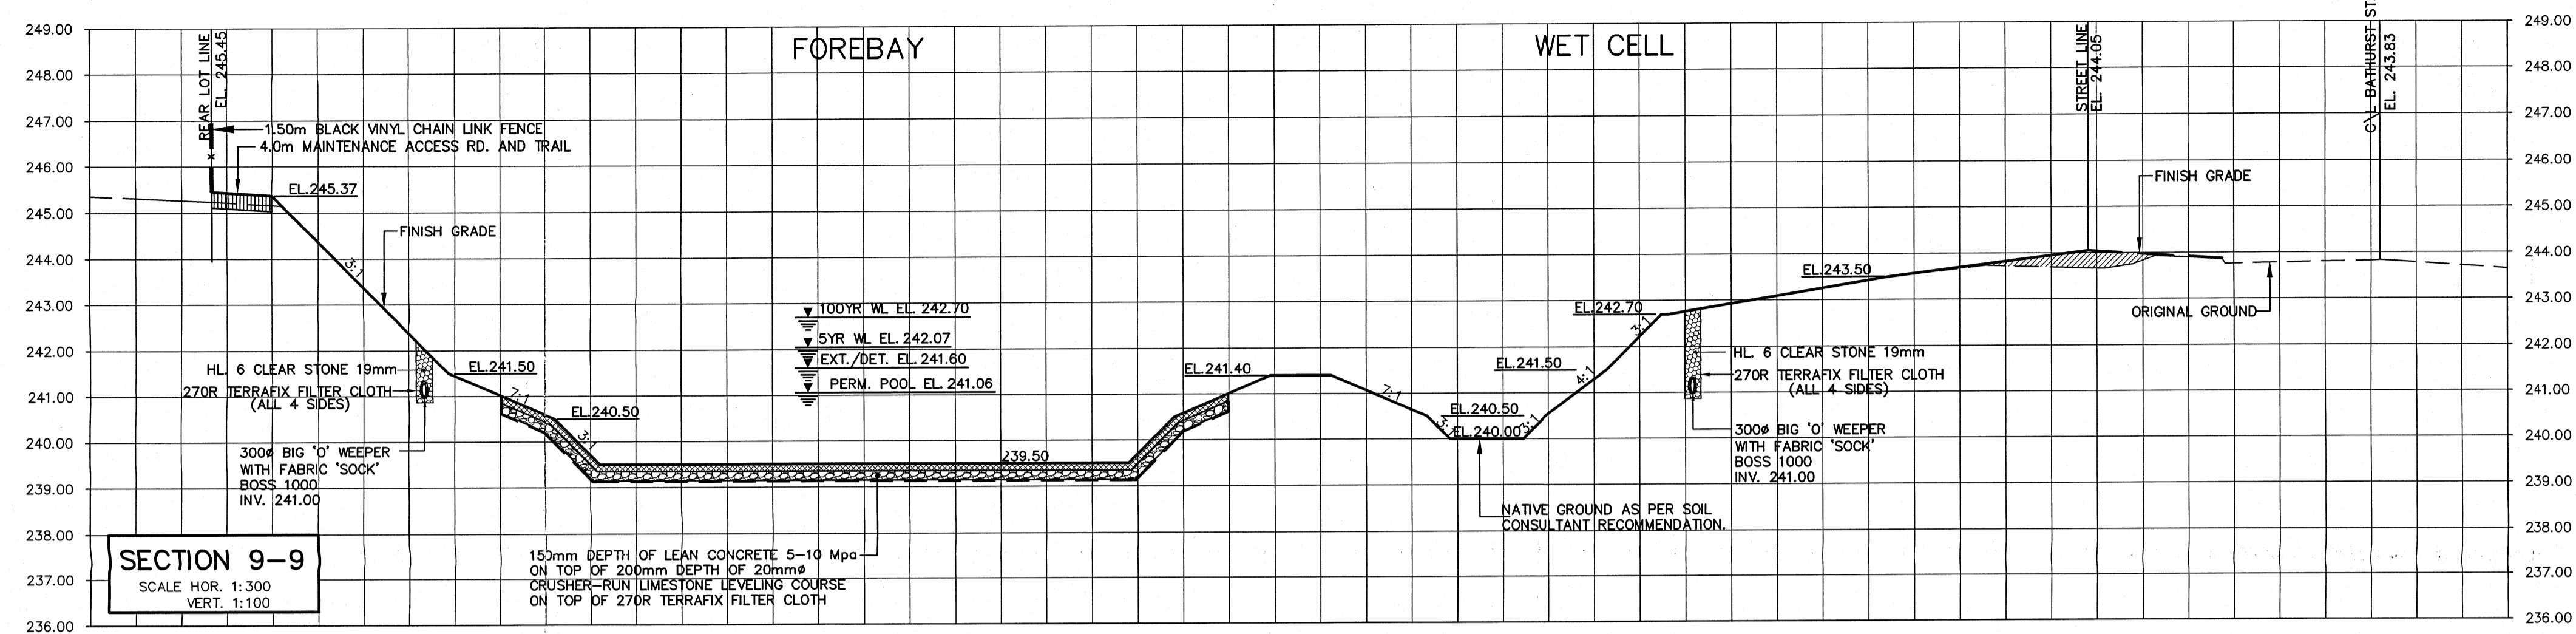

AS CONSTRUCTED FEBRUARY 2008

BENCH MARK No.
 ELEVATIONS SHOWN HEREON ARE GEODETIC AND ARE REFERRED TO CITY OF VAUGHAN BENCHMARK No. 12-1 CONCRETE BENCH MARK POST WEST SIDE OF BATHURST STREET 183m NORTH OF MAJOR MACKENZIE DRIVE HAVING A PUBLISHED ELEVATION OF 232.309m

APPROVED AS TO FORM IN RELIANCE, UPON THE PROFESSIONAL SKILL AND ABILITY OF SCHAEFFERS CONSULTING ENGINEERS AS TO DESIGN AND SPECIFICATION (PHASE 1 SPINE ONLY)

CONSTRUCTION DRAWING
JUNE 30, 2011

DIRECTOR OF DEVELOPMENT/ TRANSPORTATION ENGINEERING DATE

BLOCK 12 SPINE SERVICES

SCHAEFFERS
 CONSULTING ENGINEERS

SCHAEFFER & ASSOCIATES LTD.

6 Ronrose Drive, Concord,
 Ontario L4K 4R3
 Tel: (905) 738-6100
 Fax: (905) 738-6875
 E-mail: design@schaeffers.com











PROJECT No.	2004-2644	DRAWING No.	SWM 4-4
SCALE	HORIZONTAL	0 5 10 15 20 25 30 35 40 45 50m	
	VERTICAL	0 1 2 3 4 5 6 7 8 9 10m	



SWM POND No. 4
 SECTIONS 9-9 TO 12-12

DESIGNED BY: A.B.O.	DATE: MAY 2005	CHECKED BY: H.T.
DRAWN BY: AMR/Acad		APPROVED BY:
SCALE: AS SHOWN		DWG. No.

REVISIONS			
No.	DESCRIPTION	By	Date

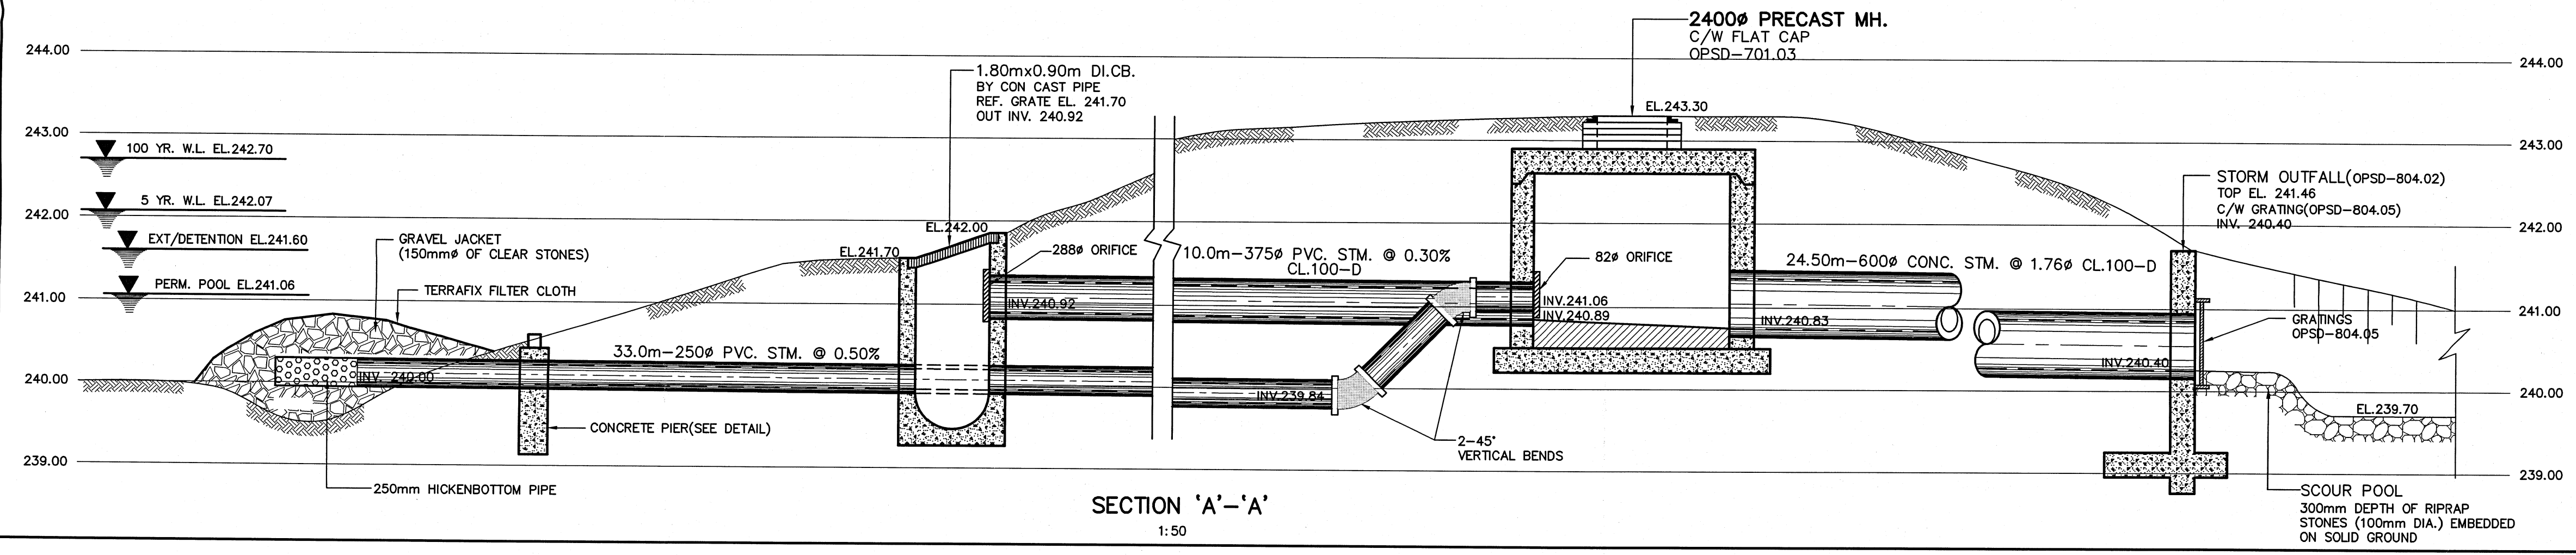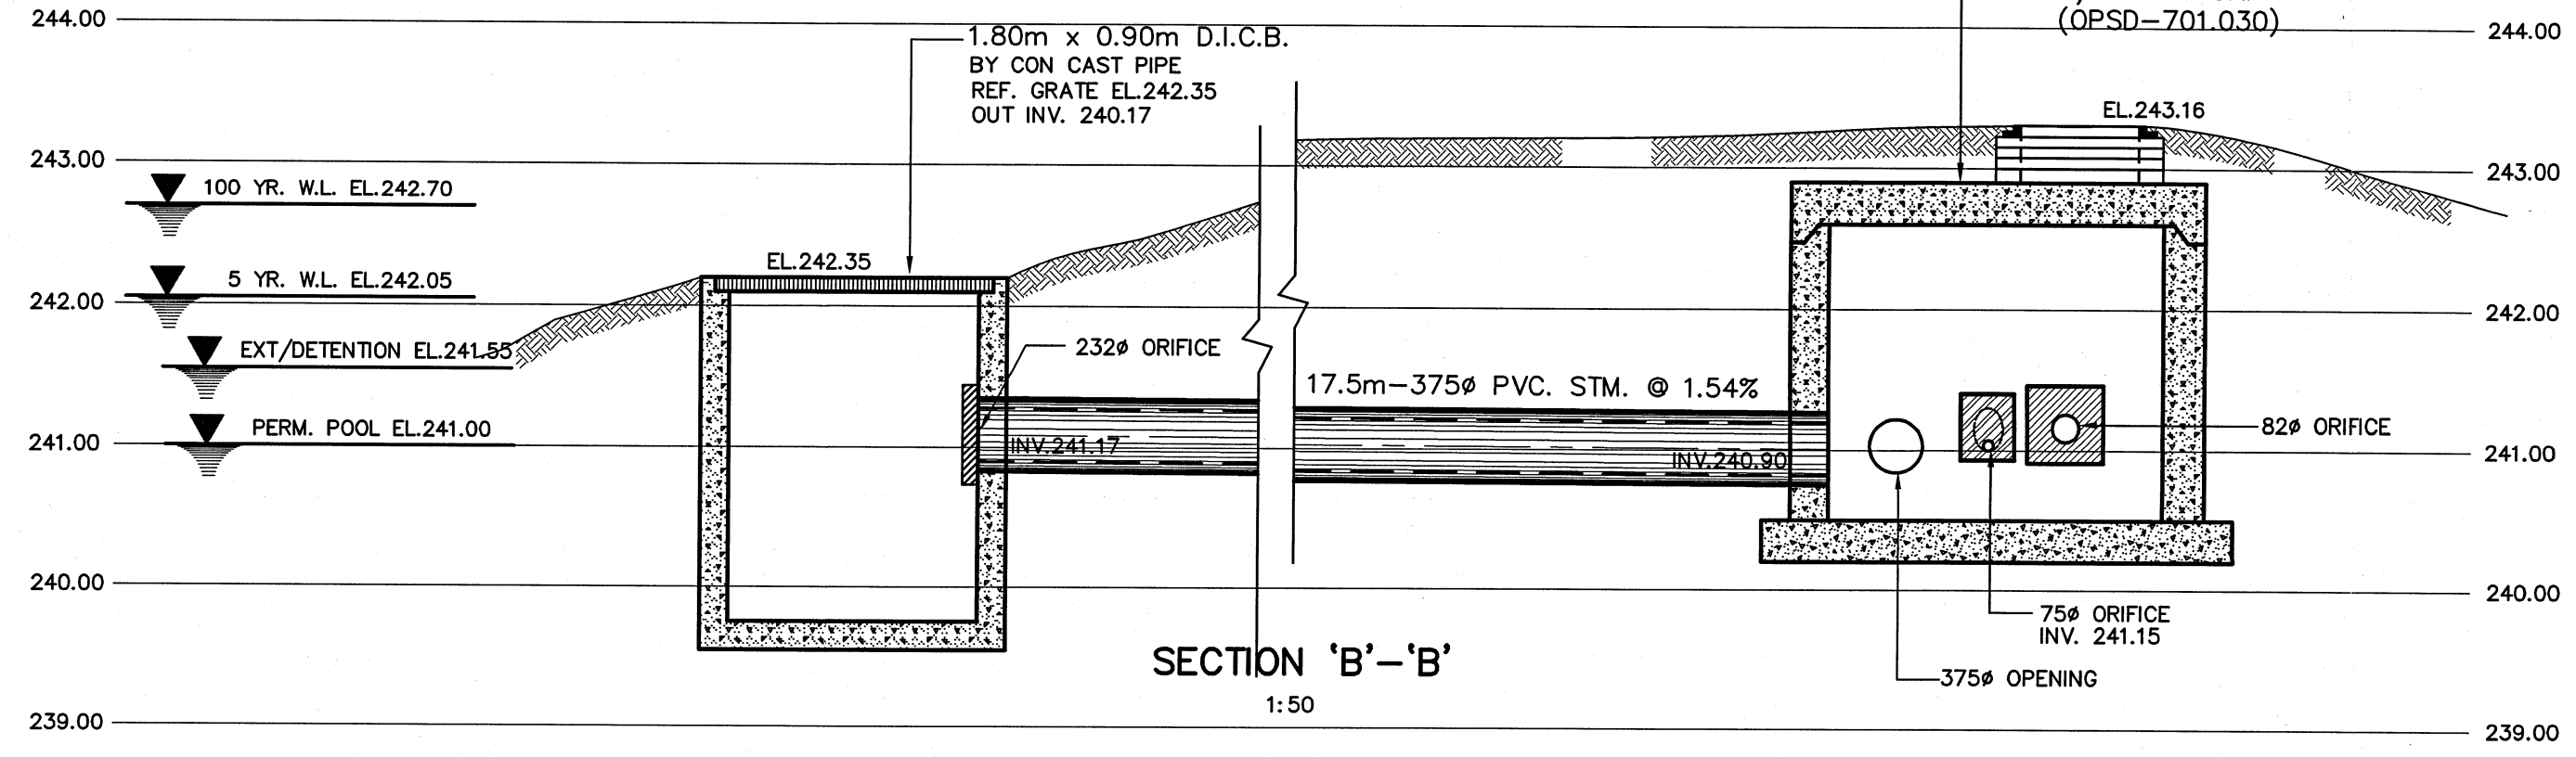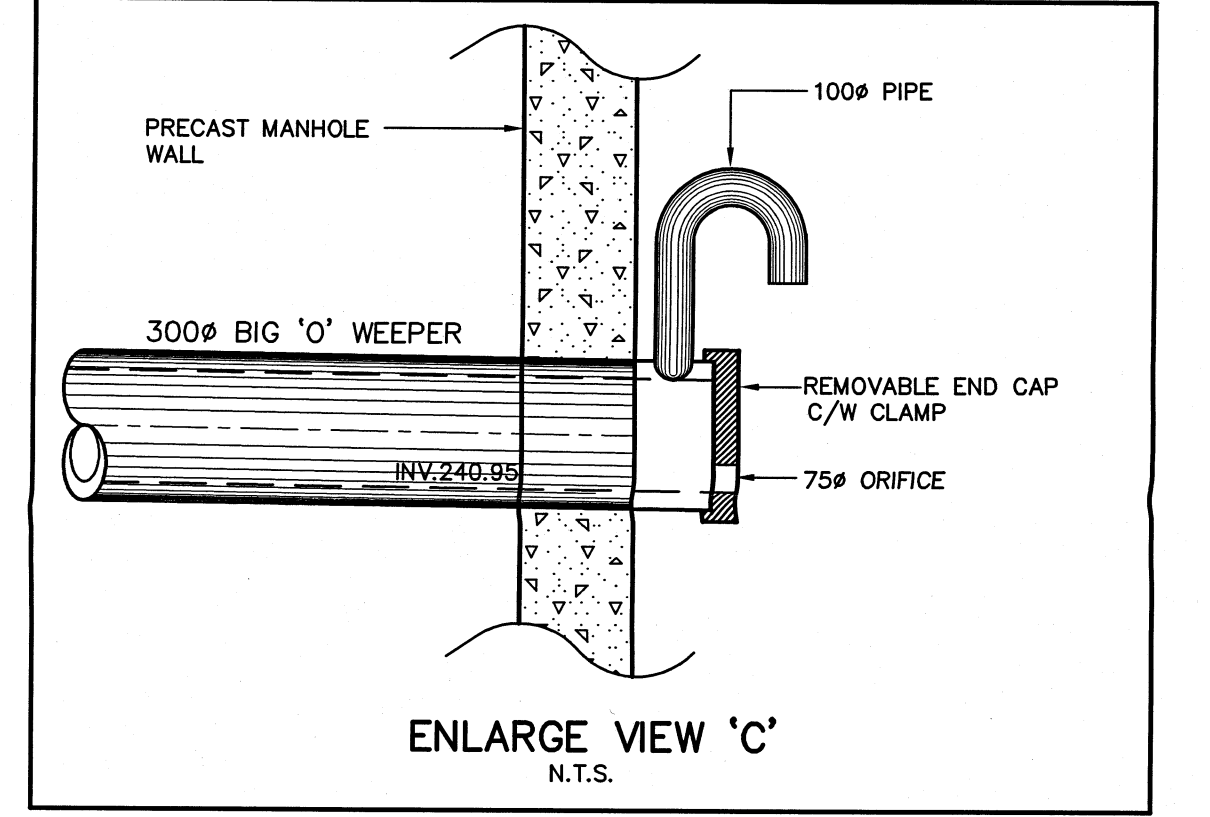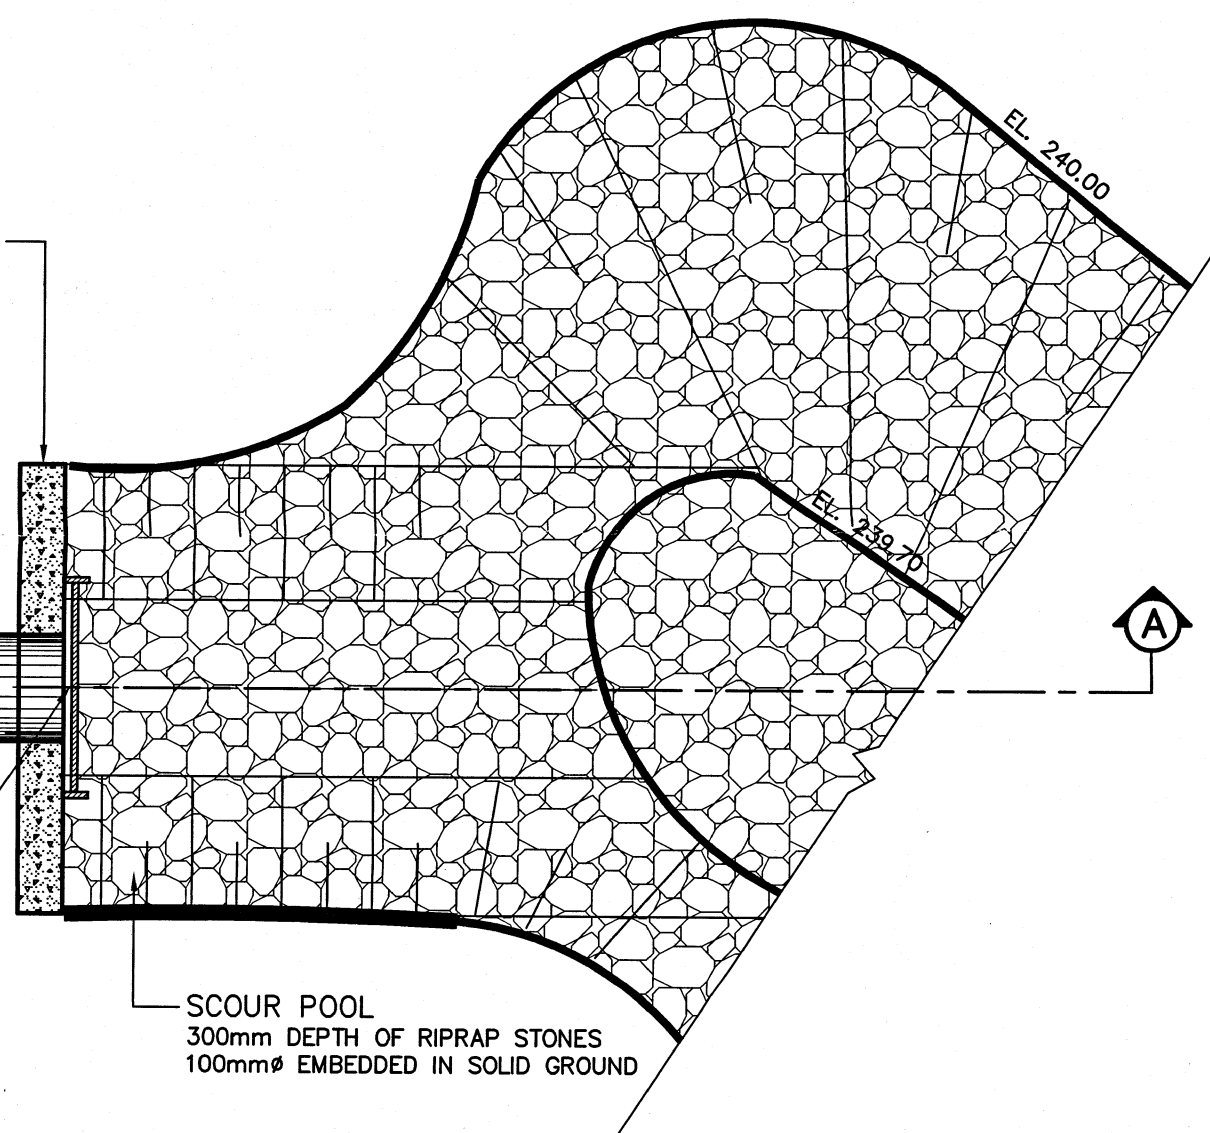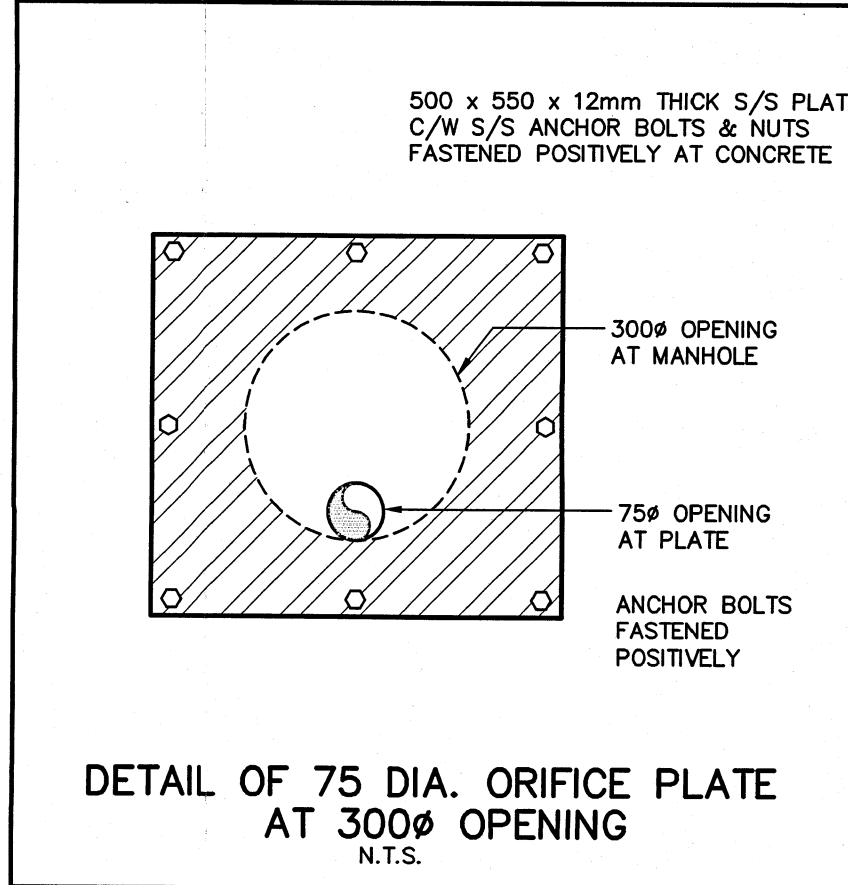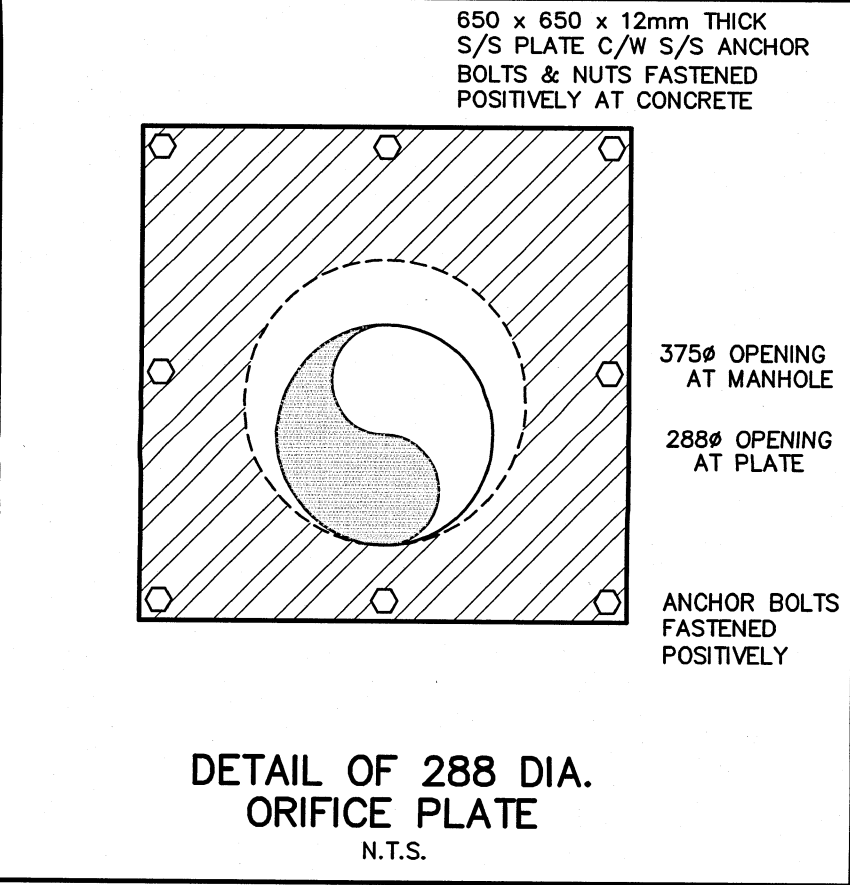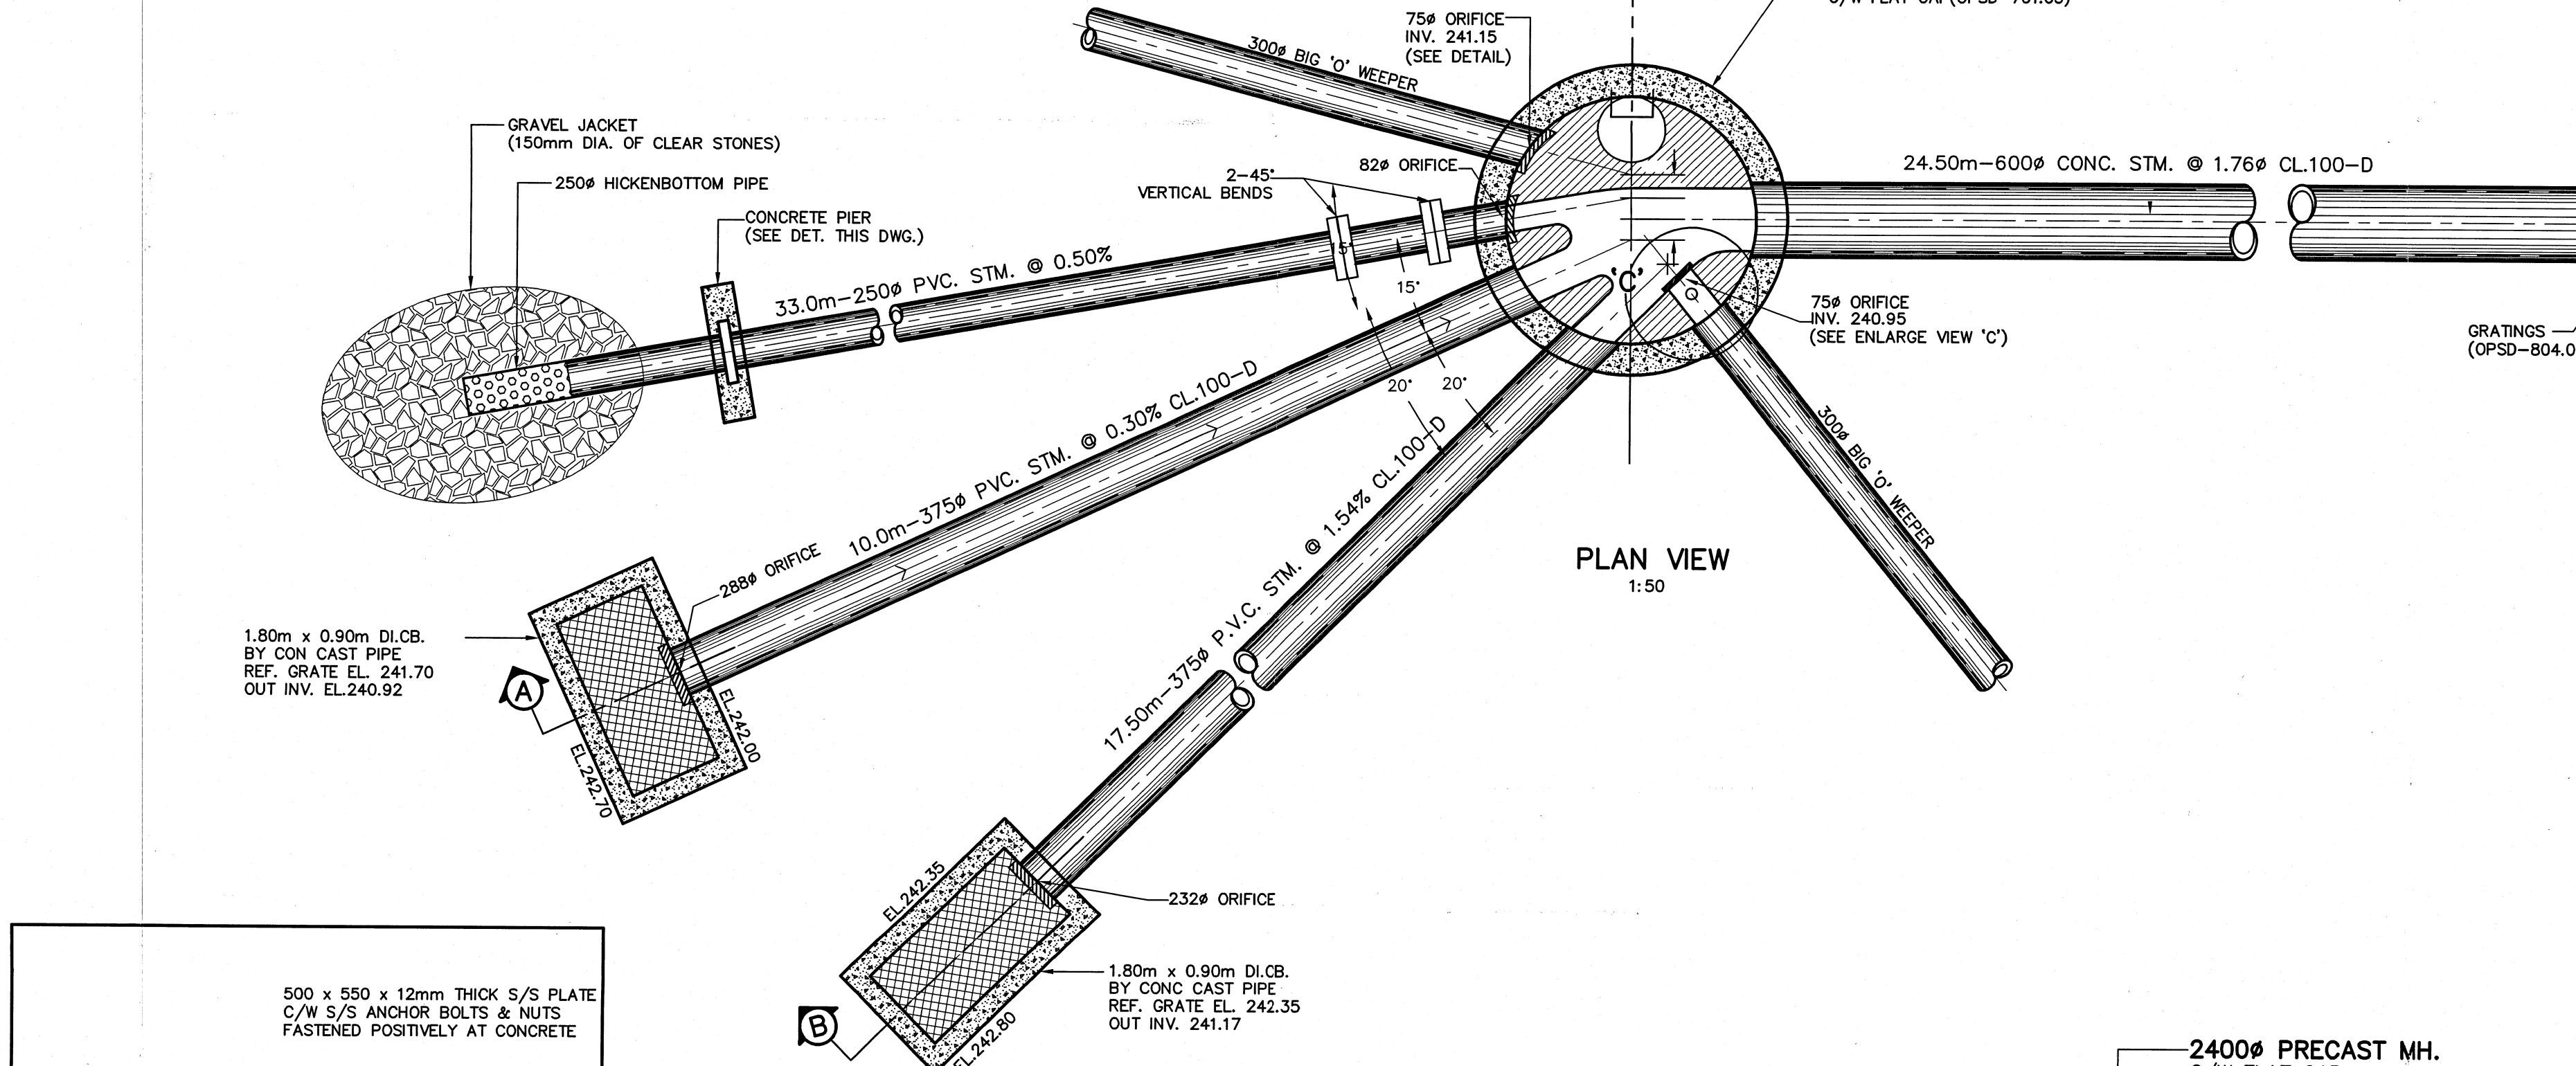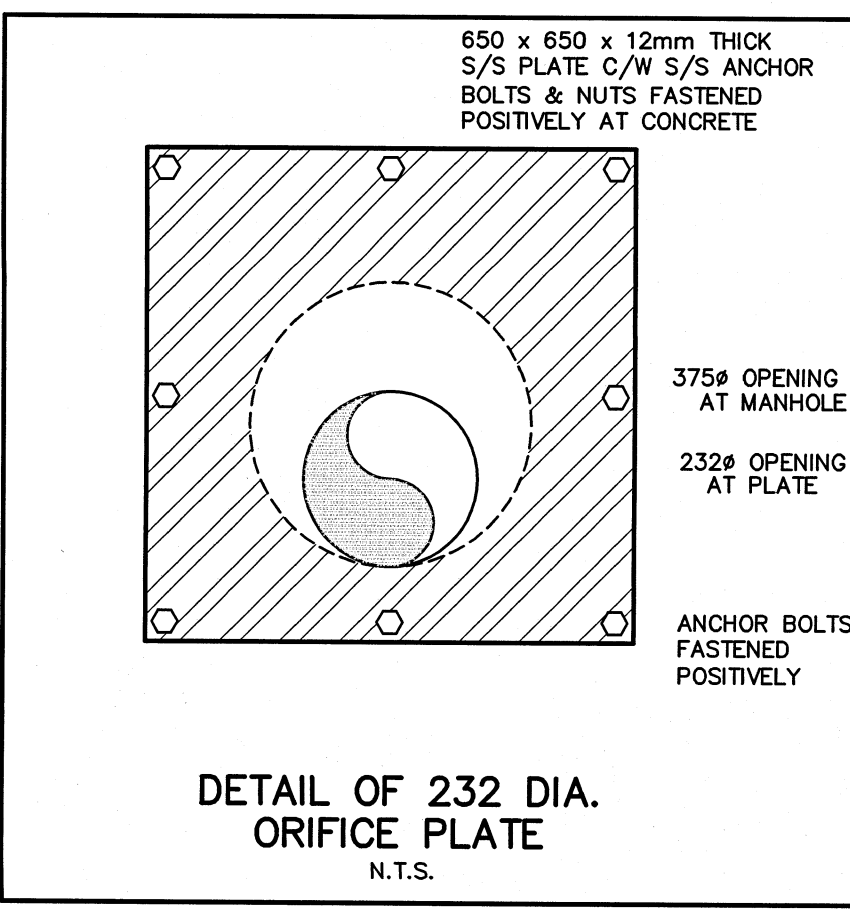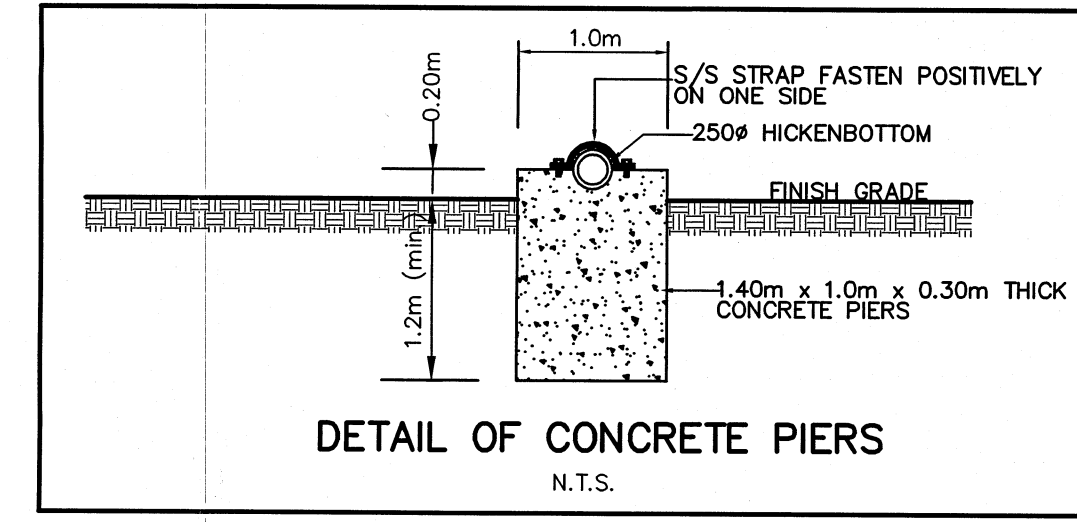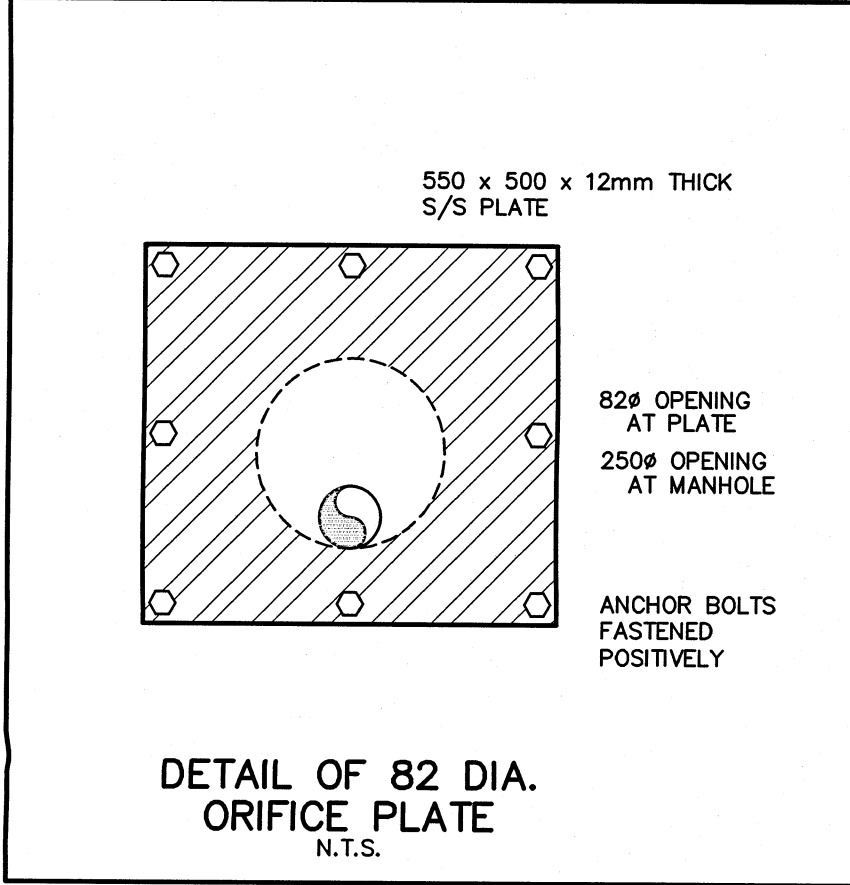

AS CONSTRUCTED FEBRUARY 2008

REGISTERED PROFESSIONAL ENGINEER
H. O. TOZCU
JULY 2009
PROVINCE OF ONTARIO

APPROVED AS TO FORM IN RELIANCE UPON THE PROFESSIONAL SKILL AND ABILITY OF SCHAEFFERS CONSULTING ENGINEERS AS TO DESIGN AND SPECIFICATION (PHASE 1 SPINE ONLY)

Vaughan
The City Above Toronto

CONSTRUCTION DRAWING
June 30, 2011

DIRECTOR OF DEVELOPMENT/ TRANSPORTATION ENGINEERING DATE

BLOCK 12 SPINE SERVICES

SCHAEFFERS
CONSULTING ENGINEERS

6 Ronrose Drive, Concord, Ontario L4K 4R3
Tel: (905) 738-6100
Fax: (905) 738-6875
E-mail: design@schaeffers.com

SCHAEFFER & ASSOCIATES LTD.

PROJECT No. 2004-2644 DRAWING No. SWM 4-5

S C A L E

HORIZONTAL 0 5 10 15 20 25 30 35 40 45 50m

VERTICAL 0 1 2 3 4 5 6 7 8 9 10m

Vaughan
The City Above Toronto

BLOCK 12
DETAIL OF
CONTROL FLOW STRUCTURE - POND No. 4

DESIGNED BY: A.B.O. DATE: AUG. 2004 CHECKED BY:

DRAWN BY: AMR/Acad APPROVED BY:

SCALE DWG. No.

APPENDIX E

SWM Pond Sizing Calculations

File: 2004-2644
Date: October 2013
SWM Pond 4

Custom Hickenbottom Calculations		
Calculate Maximum Amount of holes		
<u>Input:</u>		
	Pipe Diameter	250 mm
	Pipe Length	1 m
	Size of holes	25 mm
	Spacing of holes	50 mm
<u>Output:</u>	Number of Holes	<u>117</u>
<u>Check Area</u>	Area of holes	57344 mm ²
	Interpolated Diam	270 mm
	Orifice Diam Req'd	82 mm
	Therefore O.K	

Sediment Forebay Berm Sizing - Block 12 SWM Pond 4		
Forebay Settling Length		
<u>Input:</u>		
R=	2.5	Length to width ratio
Q _p =	0.01 m ³ /s	Peak flow rate from 25 mm event
V _s =	0.0003 m/s	Settling velocity , typically 0.0003
<u>Output:</u>		
Distance=	9 m	Forebay Length
Dispersion Length		
<u>Input:</u>		
Q=	5.82 m ³ /s	Inlet flowrate, typically 5 yr + 10 %
d=	1.56 m	Depth of permanent pool
V _f =	0.5 m/s	desired velocity, typically 0.5
<u>Output:</u>		
Distance=	60 m	Forebay Length
Width=	7	Minimum Forebay bottom Width

APPENDIX B: Existing Drainage Elements and Site Investigation Photos

Culvert/Site Inspection for Teston Road

Culvert #ED02



Culvert Field Investigation Data Sheet (Culvert #ED02)

Date (mm/dd/yy): <i>10/26/2022</i>	Field Crew: <i>Jenny Dai, Ken Luong</i>
Client: <i>York Region</i>	Highway/Road No.: <i>Teston rd.</i>
Culvert Crossing Type: <i>Centreline Culvert</i>	Blockage in Culvert: <i>no</i>
Culvert Material: <i>Concrete</i>	Culvert Condition: <i>Good</i>
Culvert Shape: <i>Circular</i>	Inlet Condition: <i>Good</i>
Culvert Bottom:	Outlet Condition: <i>Good</i>
Culvert Flow Direction: <i>SW (Downstream)</i>	Additional Field Notes: <i>Inlet: Near inlet, two small diameter trees (< 10cm)</i> <i>About 10 cm of sediment at inlet</i> <i>Outlet: Outlet has plunge pool</i> <i>Overall: Field measured 800mm concrete pipe, with HW</i> <i>Good condition, not much sediment</i> <i>no water</i> <i>Recommendation:</i>
Culvert Size (mm): <i>31.5" (800mm)</i>	
Depth of Water in Culvert: <i>no water</i>	

Site Photograph Photo of Culvert ED02: Upstream End



*Site Photograph Photo of Culvert ED02:
Downstream End*



Culvert #ED03



Culvert Field Investigation Data Sheet (Culvert #ED03)

Date (mm/dd/yy): <i>10/26/2022</i>	Field Crew: <i>Jenny Dai, Ken Luong</i>
Client: <i>York Region</i>	Highway/Road No.: <i>Teston Rd.</i>
Culvert Crossing Type: <i>Centreline Culvert</i>	Blockage in Culvert: <i>no</i>
Culvert Material: <i>Concrete</i>	Culvert Condition: <i>good</i>
Culvert Shape: <i>Circular</i>	Inlet Condition: <i>good</i>
Culvert Bottom:	Outlet Condition: <i>good</i>
Culvert Flow Direction: <i>north to south</i>	Additional Field Notes: <i>Inlet: Inlet invert perched by about 200mm; headwall</i> <i>Outlet: outlet has a headwall</i> <i>Outlet to ditch and ditch ID to into STM network</i> <i>Ditch and culvert flows into STM network via DI</i> <i>Recommendation:</i>
Culvert Size (mm): <i>35.4" (900mm)</i>	
Depth of Water in Culvert (mm):	

Site Photograph Photo of Culvert ED03: Upstream End



Site Photograph Photo of Culvert ED03: Downstream End



Culvert #ED04



Culvert Field Investigation Data Sheet (Culvert #ED04)

Date (mm/dd/yy): <i>10/26/2022</i>	Field Crew: <i>Jenny Dai, Ken Luong</i>
Client: <i>York Region</i>	Highway/Road No.: <i>Teston rd.</i>
Culvert Crossing Type: <i>Centreline Culvert</i>	Blockage in Culvert: <i>no</i>
Culvert Material: <i>Concrete</i>	Culvert Condition: <i>good</i>
Culvert Shape: <i>Box</i>	Inlet Condition: <i>good</i>
Culvert Bottom: <i>Open footing</i>	Outlet Condition: <i>good</i>
Culvert Flow Direction: <i>North to South</i>	Additional Field Notes: <i>Inlet: Field measured opening= 1500mm under slab to top of sediment</i> <i>Outlet: Field measured opening= 1400mm under slab to top of sediment</i> <i>Overall: measured outside span = 732cm</i> <i>wall thickness = 40cm</i> <i>approximate inside span = 650cm</i> <i>Skew to roadway alignment</i> <i>Recommendation:</i>
Culvert Size (mm): <i>23.6" * 70.9" (6000mm*1800mm)</i>	
Depth of Water in Culvert (mm)	


Site Photograph Photo of Culvert ED04: Upstream End



Site Photograph Photo of Culvert ED04: Downstream End and EBL Ditch



Culvert #ED05

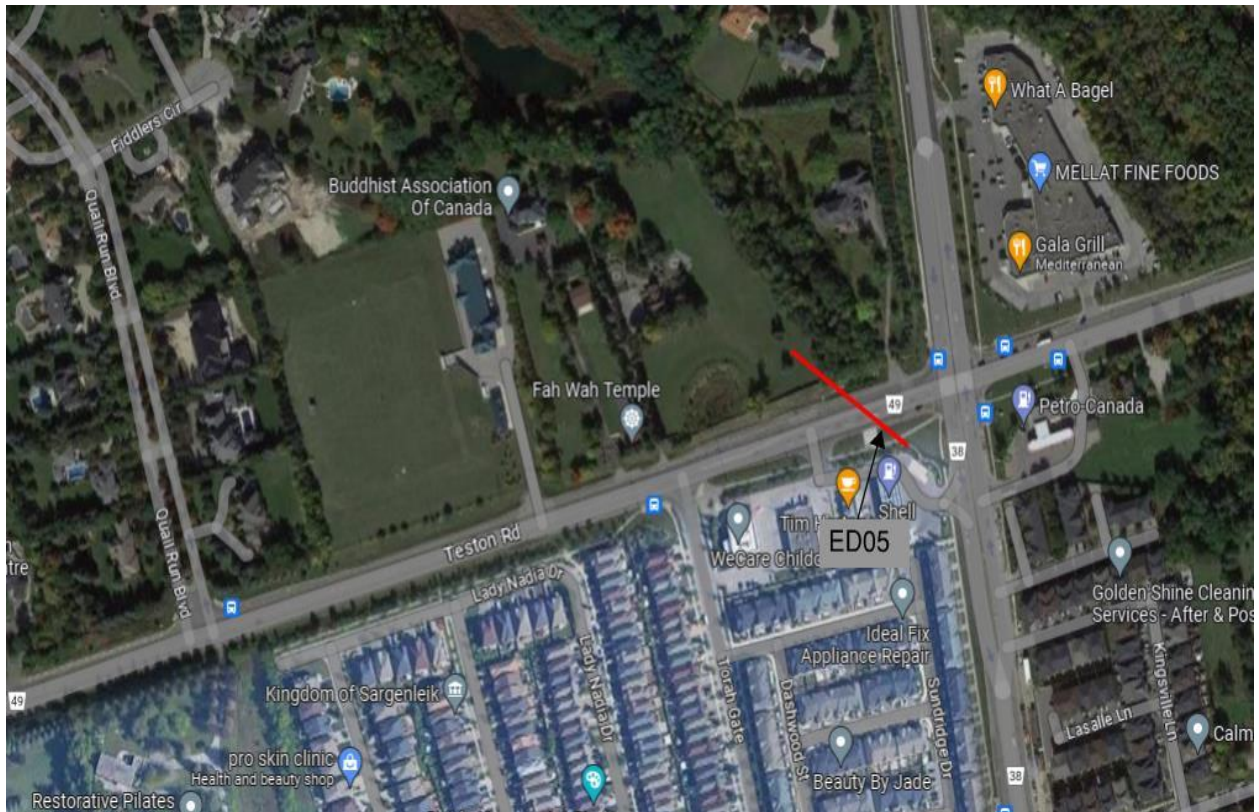

Culvert Field Investigation Data Sheet (Culvert #ED05)

Date (mm/dd/yy): <i>10/26/2022</i>	Field Crew: <i>Jenny Dai, Ken Luong</i>
Client: <i>York Region</i>	Highway/Road No.: <i>Teston Rd.</i>
Culvert Crossing Type: <i>Centreline Culvert</i>	Blockage in Culvert: <i>no</i>
Culvert Material: <i>Concrete (Upstream End) with gabion</i>	Culvert Condition: <i>good</i>
Culvert Shape: <i>Circular</i>	Inlet Condition: <i>good</i>
Culvert Bottom:	Outlet Condition: <i>N/A</i>
Culvert Flow Direction: <i>north to south</i>	Additional Field Notes: <i>Inlet:</i> <ul style="list-style-type: none">• <i>Field measured 1000mm concrete pipe embedded with stone substrate</i>• <i>2cm of water</i> <i>Outlet:</i> <i>Cannot see through to another end, suspect pipe is connected to STM sewer downstream</i> <i>Recommendation:</i>
Culvert Size (mm): <i>55" (1050mm)</i>	
Depth of Water in Culvert (mm): <i>0.78" (20mm)</i>	

Site Photograph Photo of Culvert 4: Upstream End and WBL Ditch



Site Photograph Photo of Culvert ED05:



Sewer Outlet #9



Field Investigation Data Sheet (Outlet Sewer #9)

Date (mm/dd/yy): 10/26/2022

Field Crew: Jenny Dai, Ken Luong

Highway/Road No.: Teston Rd.

Client: York Region

Additional Field Notes:

Twin CSP above outlet 9 (800mm * 12.06mm and 800mm * 12.01mm)

Site Photograph Photo of Outlet Sewer #9:



Culvert "Rail North"



Culvert Field Investigation Data Sheet (Culvert "Rail North")

Date (mm/dd/yy): <i>10/26/2022</i>	Field Crew: <i>Jenny Dai, Ken Luong</i>
Client: <i>York Region</i>	Highway/Road No.: <i>Railway</i>
Culvert Crossing Type: <i>Centreline Culvert</i>	Blockage in Culvert:
Culvert Material: <i>Concrete</i>	Culvert Condition: <i>good</i>
Culvert Shape: <i>circular</i>	Inlet Condition: <i>good</i>
Culvert Bottom:	Outlet Condition: <i>good</i>
Culvert Flow Direction: <i>East to West</i>	Additional Field Notes: <i>Overall: Field measured 900mm concrete pipe Culvert inlet, about 180cm water depth, 5cm of sediment. Recommendation:</i>
Culvert Size (mm): <i>35.4" (900mm)</i>	
Depth of Water in Culvert (mm): <i>70.9" (180mm)</i>	

Site Photograph Photo of Culvert "Rail North"



Culvert "Rail South"




Culvert Field Investigation Data Sheet (Culvert "Rail South")

Date (mm/dd/yy): <i>07/11/2023</i>	Field Crew: <i>Ken Luong</i>
Client: <i>York Region</i>	Highway/Road No.: <i>Railway</i>
Culvert Crossing Type:	Blockage in Culvert:
Culvert Material: <i>concrete</i>	Culvert Condition:
Culvert Shape: <i>circular</i>	Inlet Condition: <i>good</i>
Culvert Bottom:	Outlet Condition: <i>buried</i>
Culvert Flow Direction: <i>East to West</i>	Additional Field Notes: <i>Overall: Culvert crosses entrance roadway and railway</i> <i>Recommendation:</i>
Culvert Size (mm): <i>450</i>	
Depth of Water in Culvert (mm):	

Site Photograph Photo of Culvert "Rail South"



Culvert #WD7

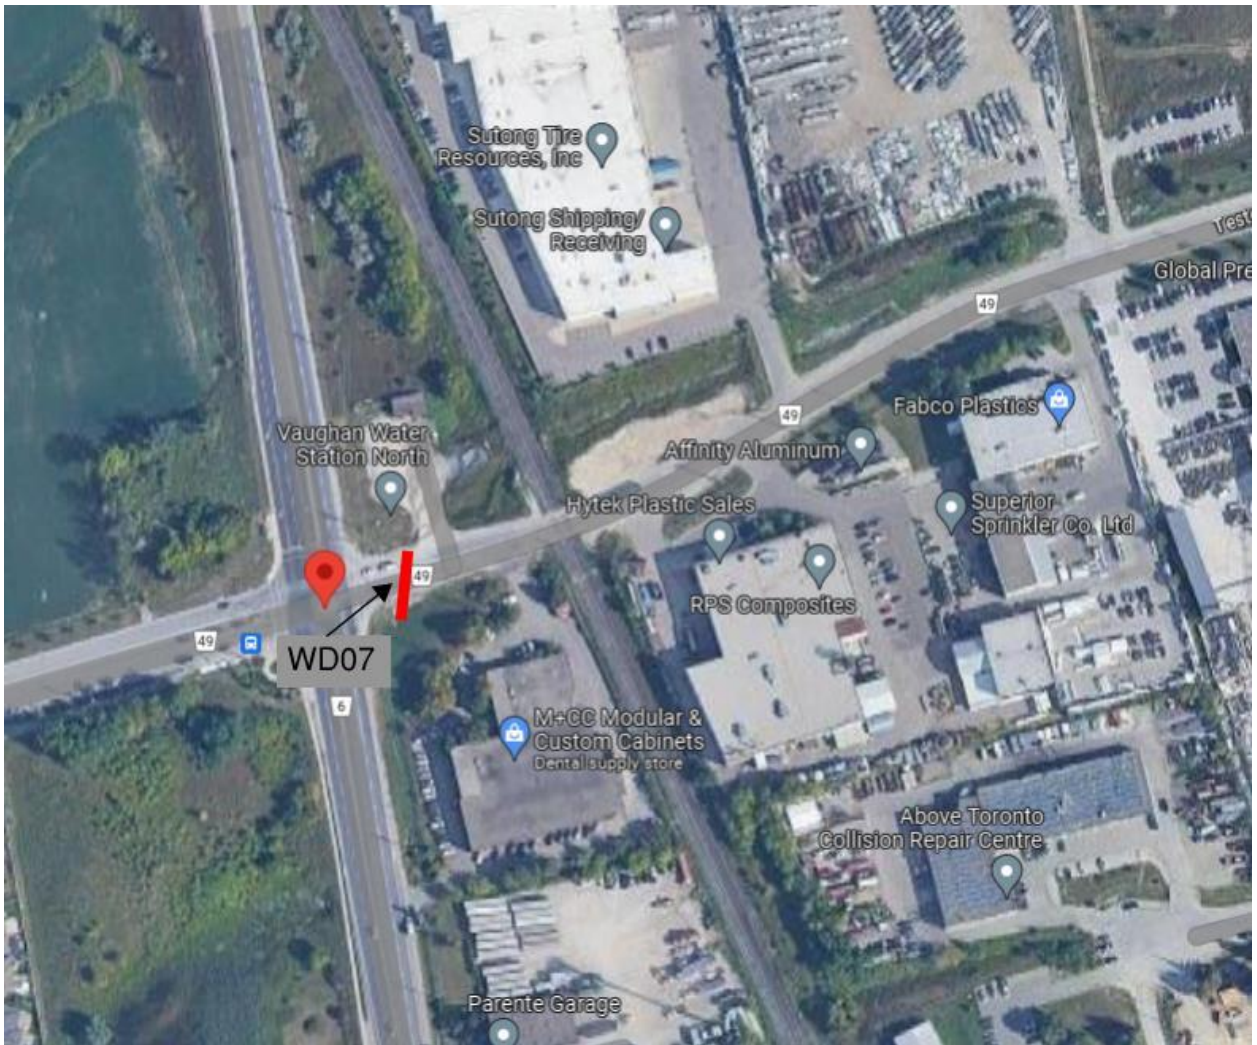

Culvert Field Investigation Data Sheet (Culvert #WD7)

Date (mm/dd/yy): <i>10/26/2022</i>	Field Crew: <i>Jenny Dai, Ken Luong</i>
Client: <i>York Region</i>	Highway/Road No.: <i>Teston Rd.</i>
Culvert Crossing Type: <i>Centreline Culvert</i>	Blockage in Culvert:
Culvert Material: <i>CSP – Corrugated Steel Pipe</i>	Culvert Condition: <i>good</i>
Culvert Shape: <i>Circular</i>	Inlet Condition: <i>good</i>
Culvert Bottom:	Outlet Condition: <i>collapsed</i>
Culvert Flow Direction:	Additional Field Notes: <i>Overall:</i> <ul style="list-style-type: none">• <i>Field measured 1350mm CSP (u/s) - About 5cm of flowing water</i>• <i>There is low lying area draining towards the culvert. But construction at time of visit obstructed actual ditch grades.</i> <i>Recommendation:</i>
Culvert Size (mm): <i>53.1" (1350mm)</i>	
Depth of Water in Culvert (mm):	

Site Photograph Photo of Culvert WD7

